


T.9S,R.24E.,W.M.

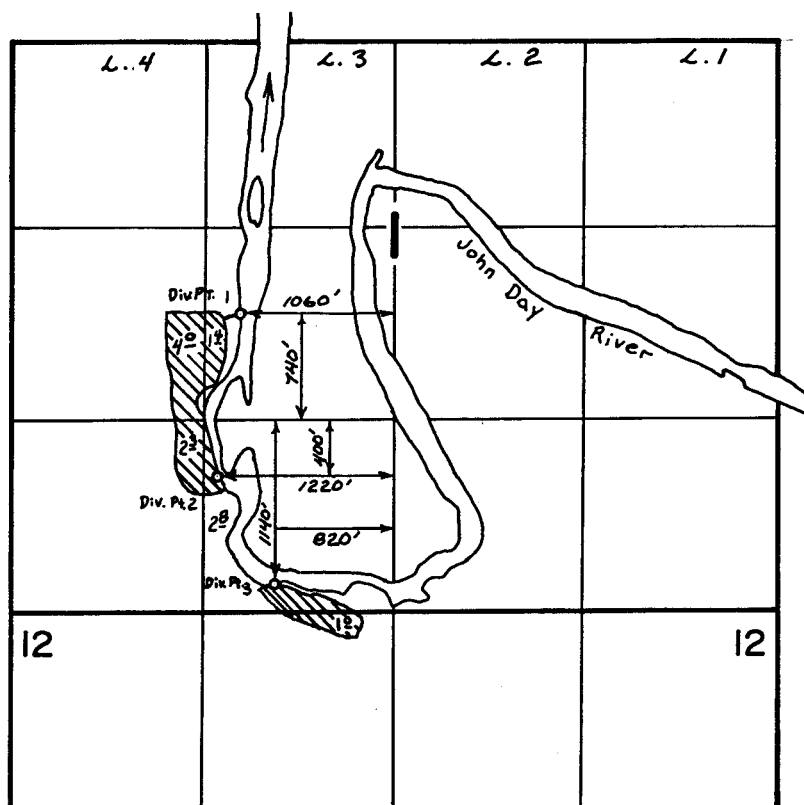

FINAL PROOF SURVEY
UNDER

Application No. 51712 Permit No. 38983
IN NAME OF

LYNN & JOANN COLLINS

Surveyed AUG. 21 1976, by D. NORBY