


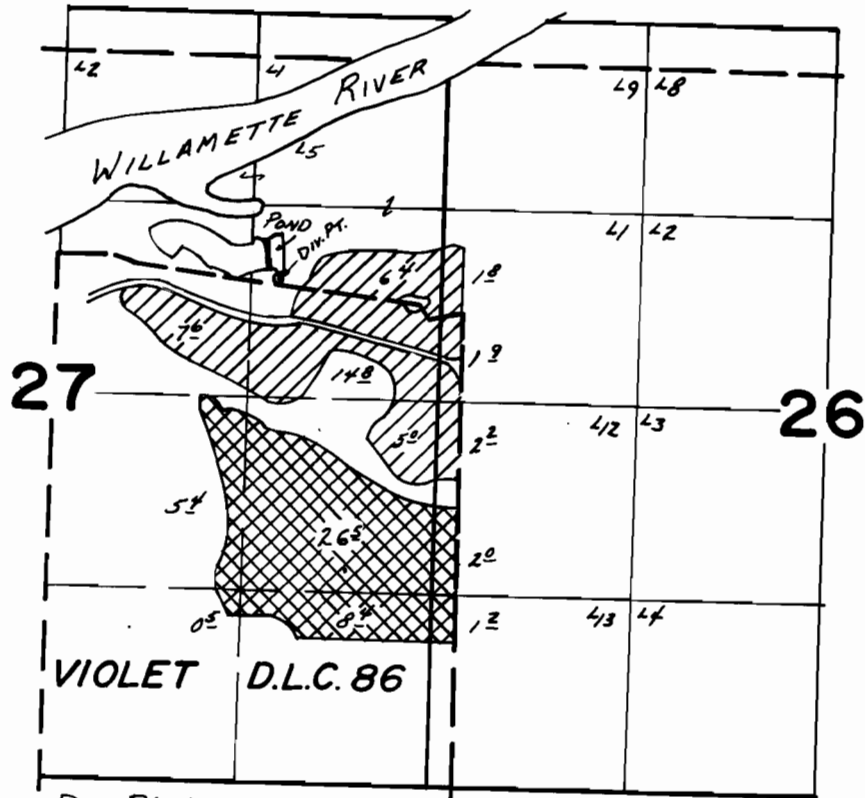

T. 4S. R. 3W. W.M.



Div. Pt. Loc. 1820'S & 1120'W from NE Cor. Sec. 27

FINAL PROOF SURVEY UNDER

 - PRIMARY
 - SUPPLEMENTAL
 TO GR-2573

Application No. G-4799 Permit No. G-4524
IN NAME OF

ROBERT B. DORSEY

Surveyed MAY 4 1978, by L.H. Nunn