


T.4S.R.5W. W.M.

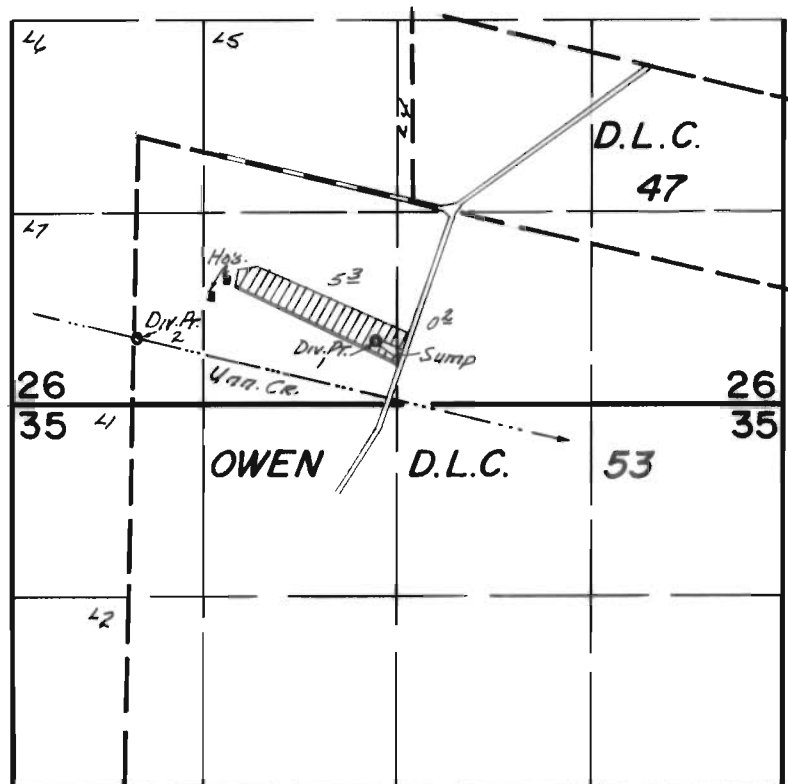

Div. Pts. - #1 - 450' N + 150' W } BOTH FROM S 1/4 Cor. Sec. 26
 2 - 450' N + 170' W }

FINAL PROOF SURVEY UNDER

Application No. 49871 36762
 G-5941 Permit No. G-5161
 IN NAME OF

James J. Manire

Surveyed June 4, 1976, by L.H. Nunn
 " May 3, 1978, " "