


T.3S.,R.3W.,W.M.

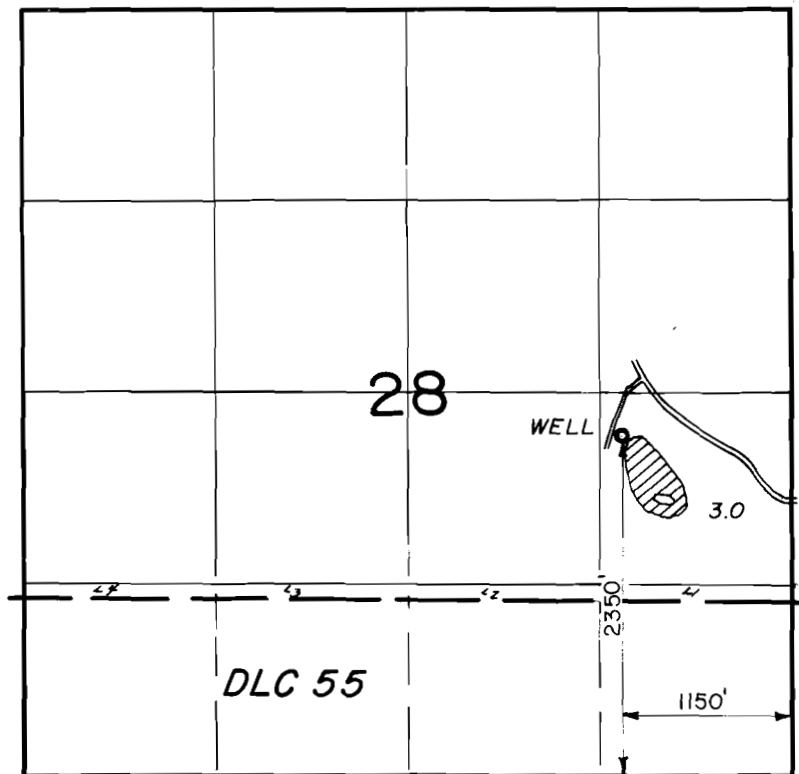

**FINAL PROOF SURVEY**  
UNDER

Application No. G-7428 Permit No. G-7248  
IN NAME OF

Chehalem Park & Recreation District

Surveyed MAY 4, 1978, by L. NUNN