


# T.4S.,R.5W.,W.M.

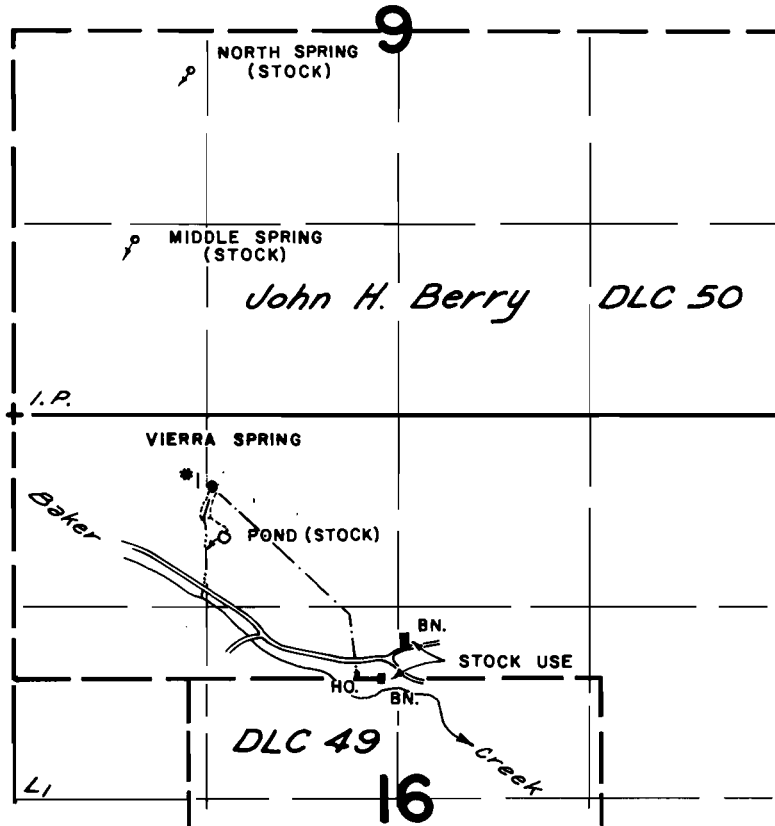

DIV. PTS. LOC: NORTH SPRING - 2370' N. & 1220' E.  
MIDDLE SPRING - 1200' N. & 840' E.  
VIERRA SPRING #1 - 480' S. & 1360' E. ALL FROM N.W. COR. SEC. 16

## FINAL PROOF SURVEY UNDER

Application No. 48549 Permit No. 36437  
IN NAME OF

E. & J. Garris, & R. Vierra

Surveyed Oct. 15, 1976 by L. H. Nunn