


Map Showing Point of Diversion, Ditches to Land
and Land Proposed to Irrigate by Mr. C. P. Bailey.

T. 12 S. - R. 9 E. W.M.

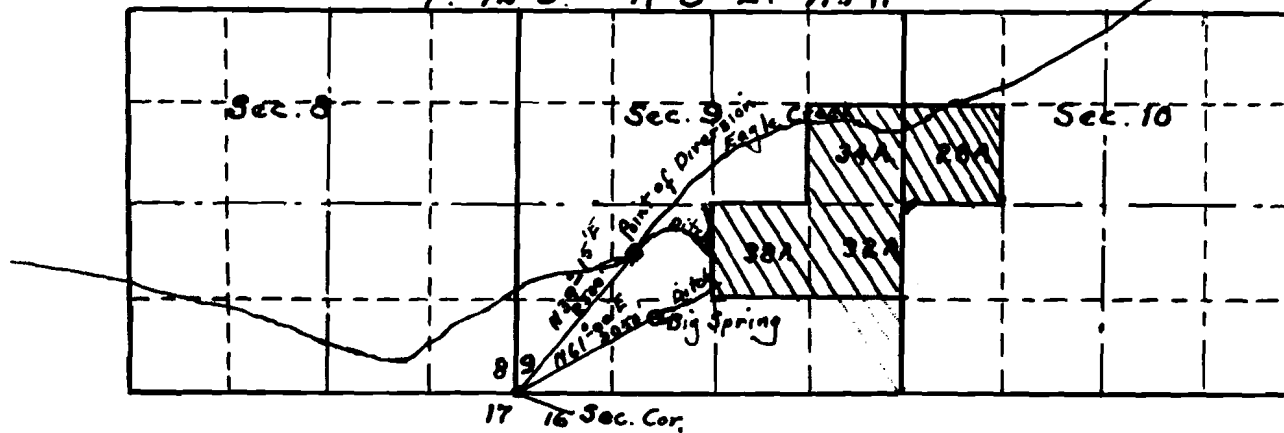

I, Roy Rannells, of Redmond, Ore., do hereby certify that this map was made from notes taken during an actual survey made by me on June 19th, 1916, and that it correctly represents the works described in the accompanying application, together with the location of streams and other ditches in the immediate vicinity, and has written thereon the area in each smallest legal subdivision which it is proposed to irrigate.

OFFICE OF STATE ENGINEER

RECEIVED

AUG 21 1916

STATE OF OREGON

Roy Rannells
Surreyor.

5129
3077

3570
41850