


T. 3 S., R. 4 W., W.M.

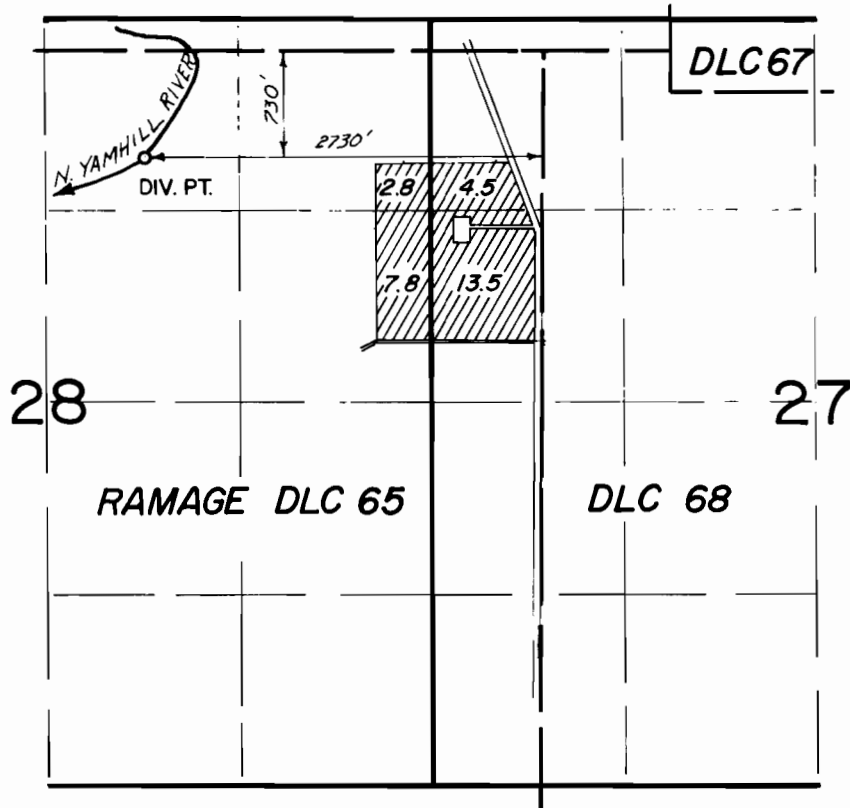

**FINAL PROOF SURVEY**  
UNDER

Application No. 48921 Permit No. 36641  
IN NAME OF

William F. Hall

Surveyed May 20, 1978, by L. Nunn