


T.6S. R.3W. W.M.

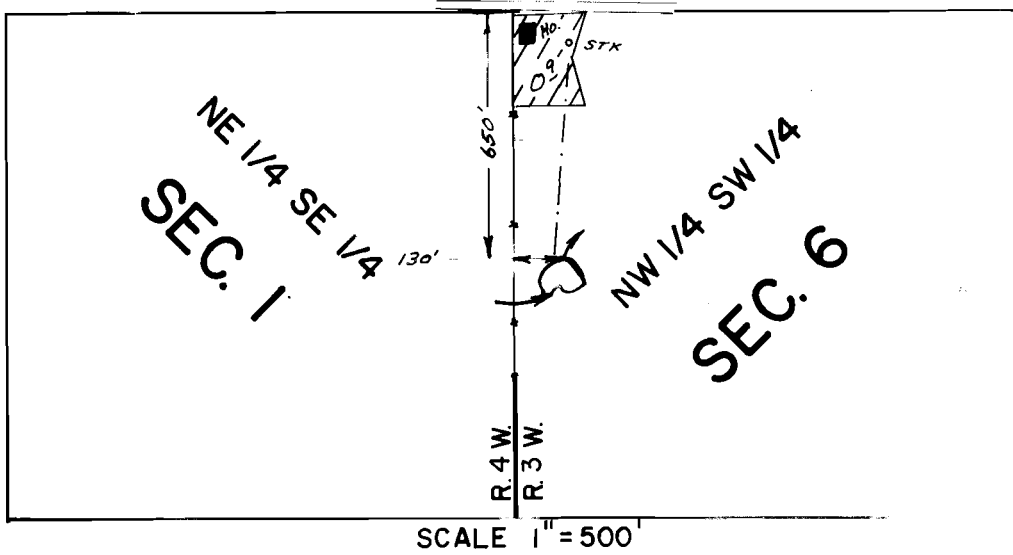

**FINAL PROOF SURVEY**  
UNDER

R-49044                      R-5946  
Application No. 49045..... Permit No. 36700.....  
IN NAME OF

.....JEANNETTE A. SPURGEON.....

Surveyed AUG. 10. 1977., by L.H. NUNN.....