


T.4S.R.5W. W.M.

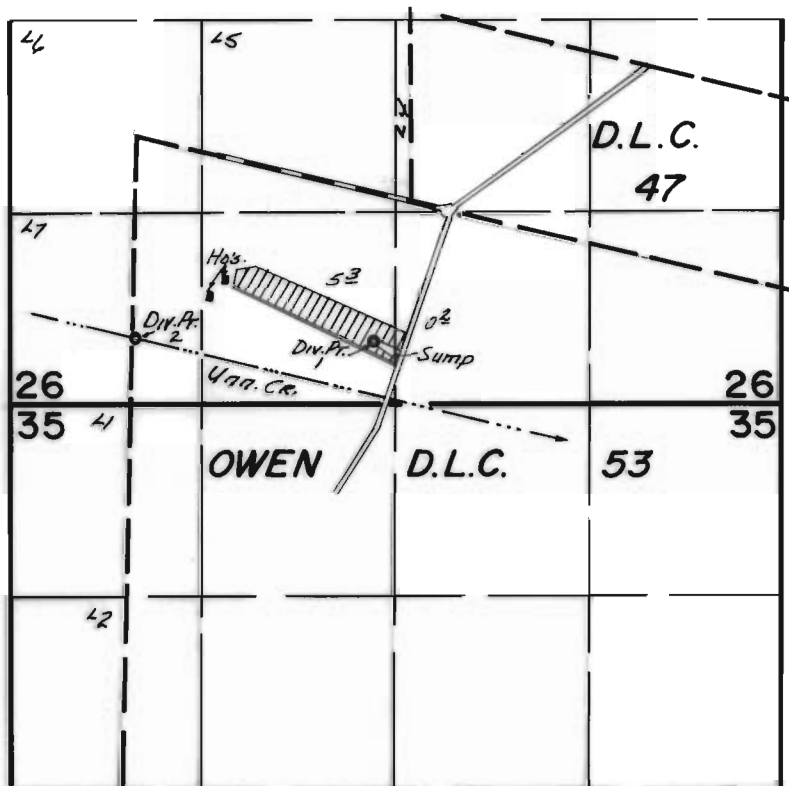

Div Pts. - #1 - 450' N & 150' W } BOTH FROM S 1/4 COR. SEC. 26
2 - 450' N & 1770' W }

FINAL PROOF SURVEY

Application No. **49871** Permit No. **36762**
G-5941 **G-5161**
 IN NAME OF

James d. Marire

Surveyed June 4, 1976, by L.H. Nunn
" May 3, 1978, " "