


T. 4S.R.5W.W.M.

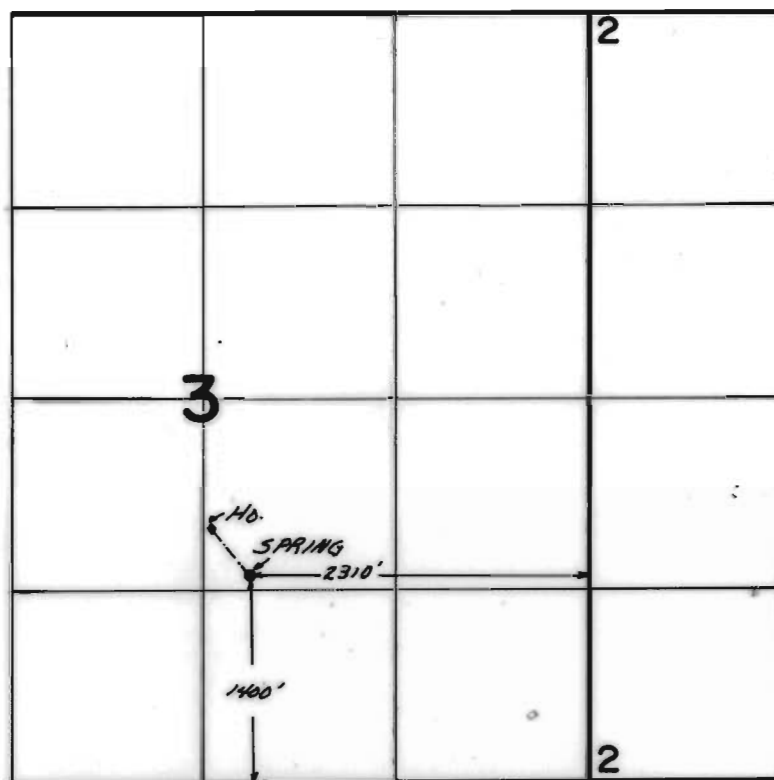

FINAL PROOF SURVEY
UNDER

Application No. 516.77.. Permit No. 3896.4.
IN NAME OF

RONALD F. & KAREN D. ENNIS.....

Surveyed May..5.... 1978, by L.H. Nunn.....