


T.4S. R.4W. W.M.

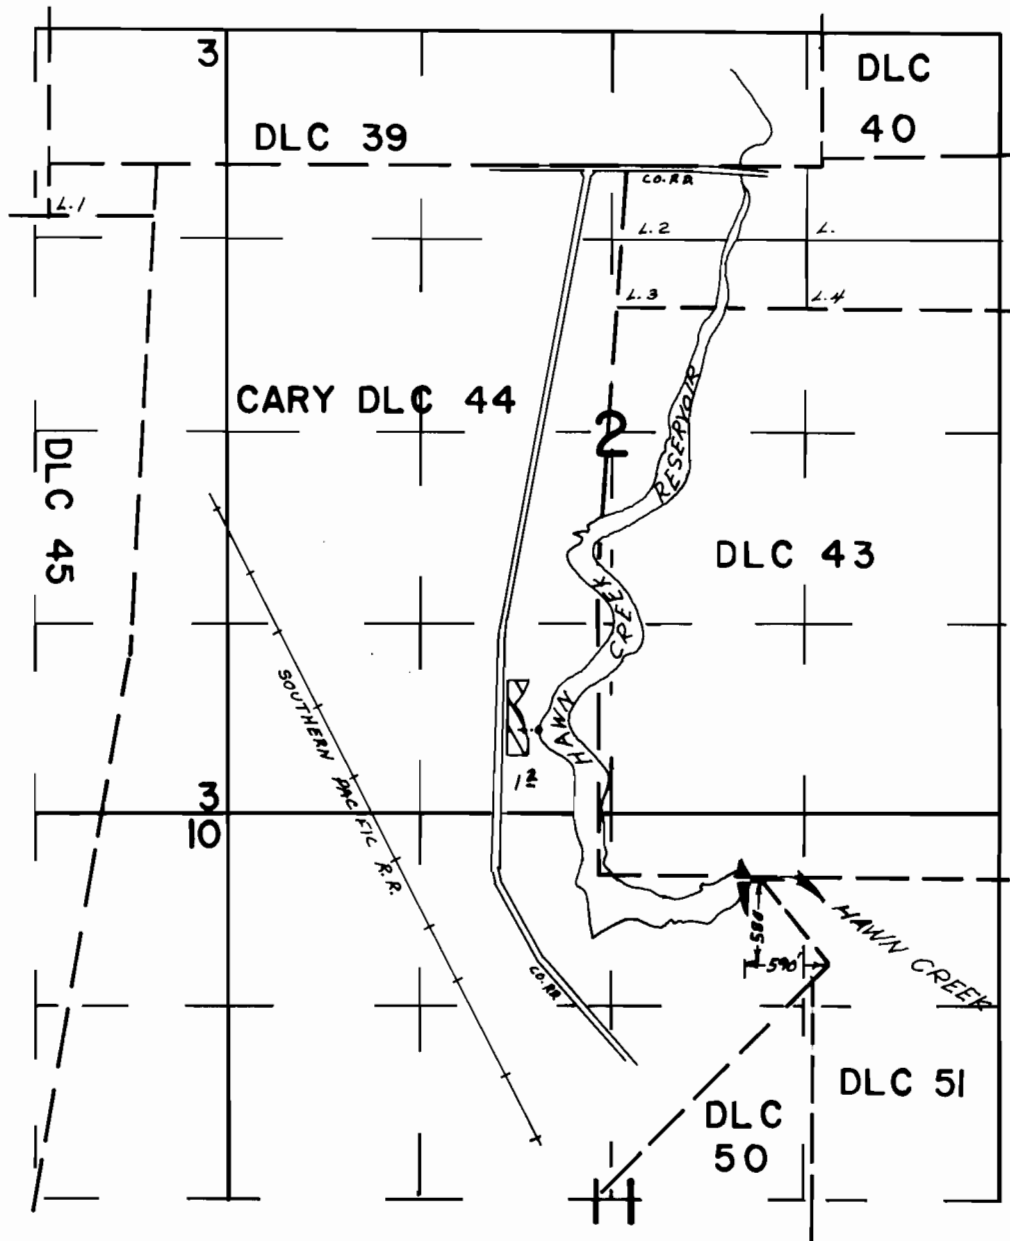

FINAL PROOF SURVEY
UNDER

Application No. 53119..... Permit No. 38598.....
IN NAME OF

GLENN & LOIS BURNHAM

Surveyed AUG. 11. 1977, by L.H. NUNN.....
MAY 9 1979 C.R. RODRIGUEZ