


T.3S., R.2W., W.M.

Section 7

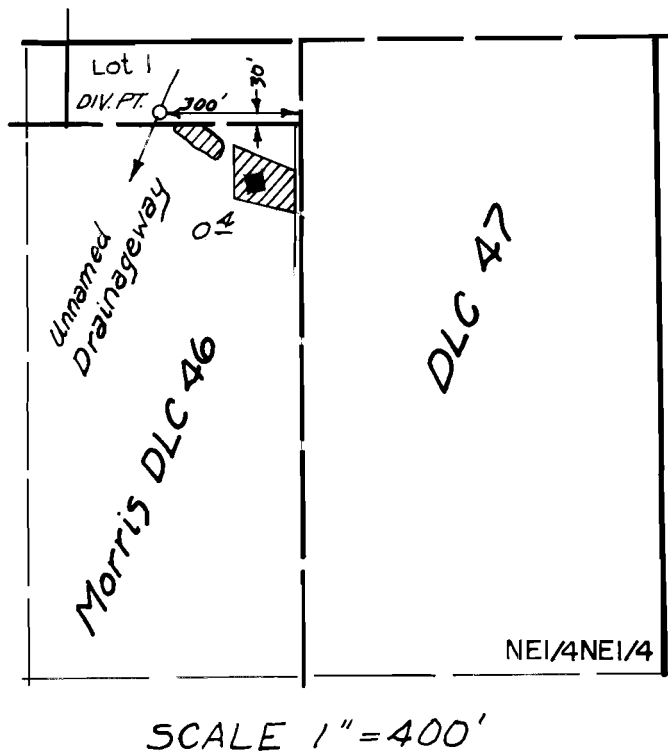

FINAL PROOF SURVEY
UNDER

Application No. 53484 Permit No. 39787
IN NAME OF

Forrest M. Gist

Surveyed May 2, 1978, by L. Nunn