T.4S. R.4W. W.M.

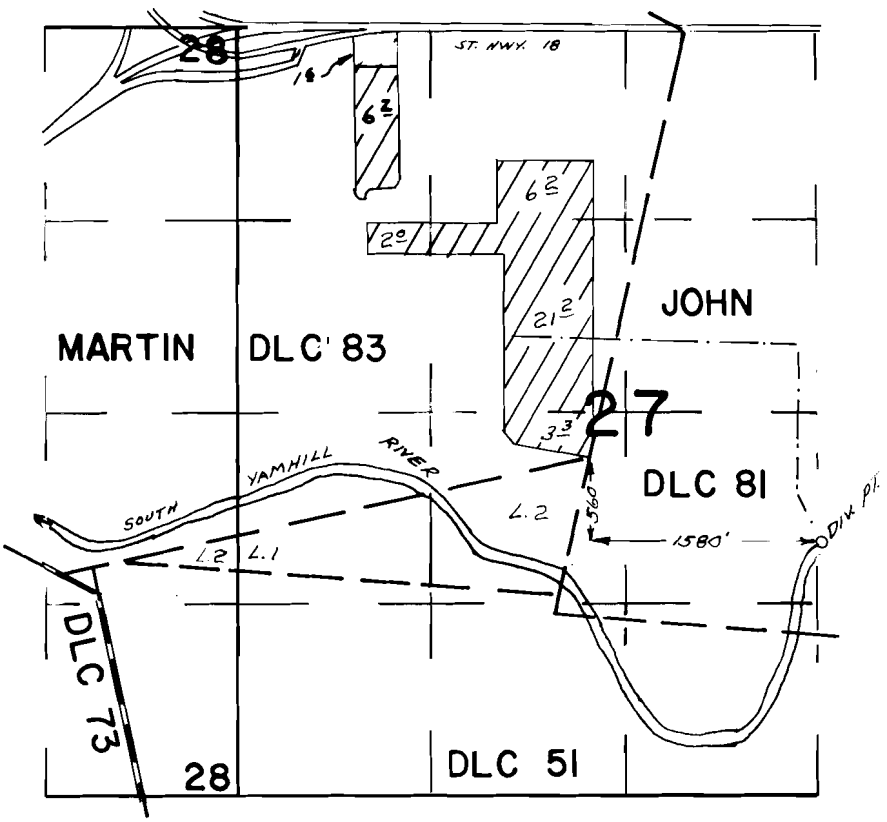

FINAL PROOF SURVEY
UNDER

Application No. 54254 Permit No. 40635
IN NAME OF

RUSSELL L. OLSON

Surveyed AUG. 12 1977, by L.H. NUNN

DFQ-1LL-161