


T.4&5S. R.4W.W.M.

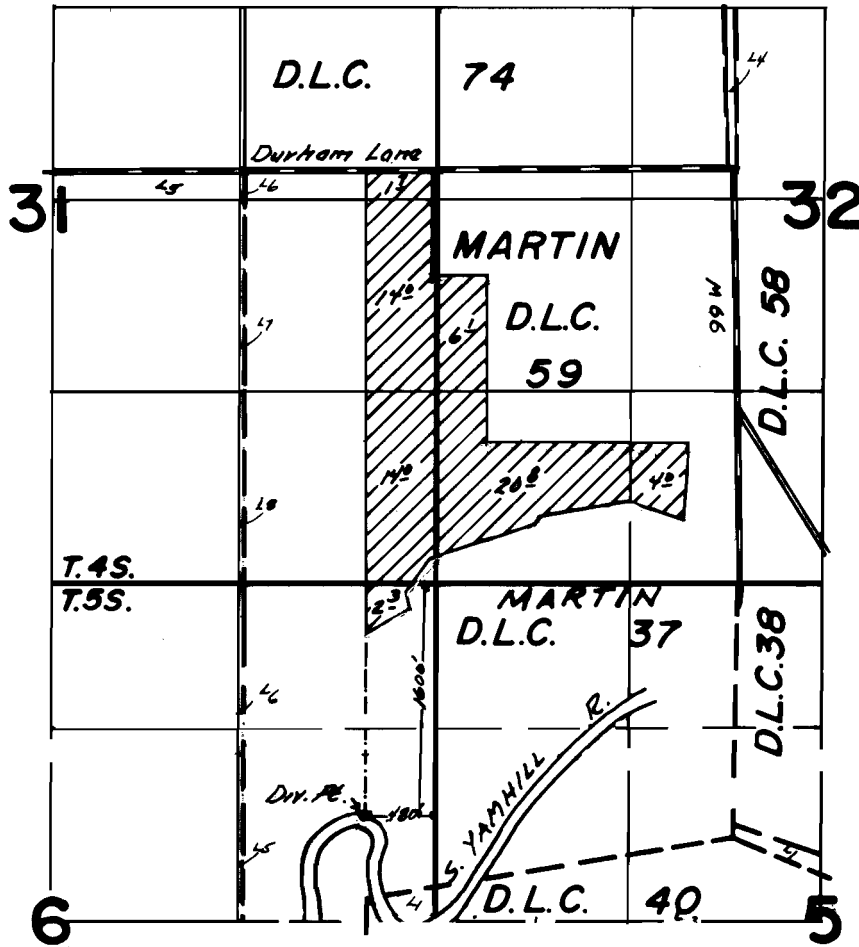

FINAL PROOF SURVEY UNDER

Application No. 55147... Permit No. 41341...
IN NAME OF

.....HERBERT C. COLEMAN.....

Surveyed March 13 1978, by L.H. Nunn.....