T.4&5S. R.4W.W.M.

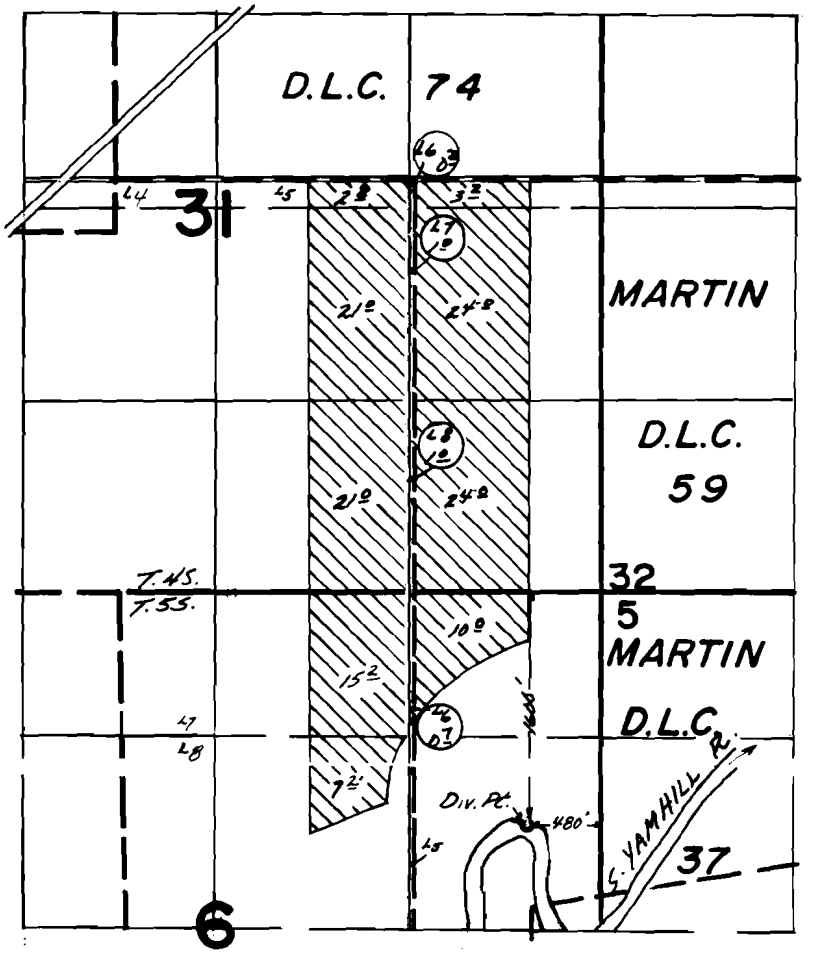

FINAL PROOF SURVEY
UNDER

Application No. 55662 Permit No. 41697
IN NAME OF

BETTY JEAN YOCKEY

Surveyed March 13 1978, by L.H. Nunn

DFQ-1LL-104 RRR