


T.4&5S.R.4W.W.M.

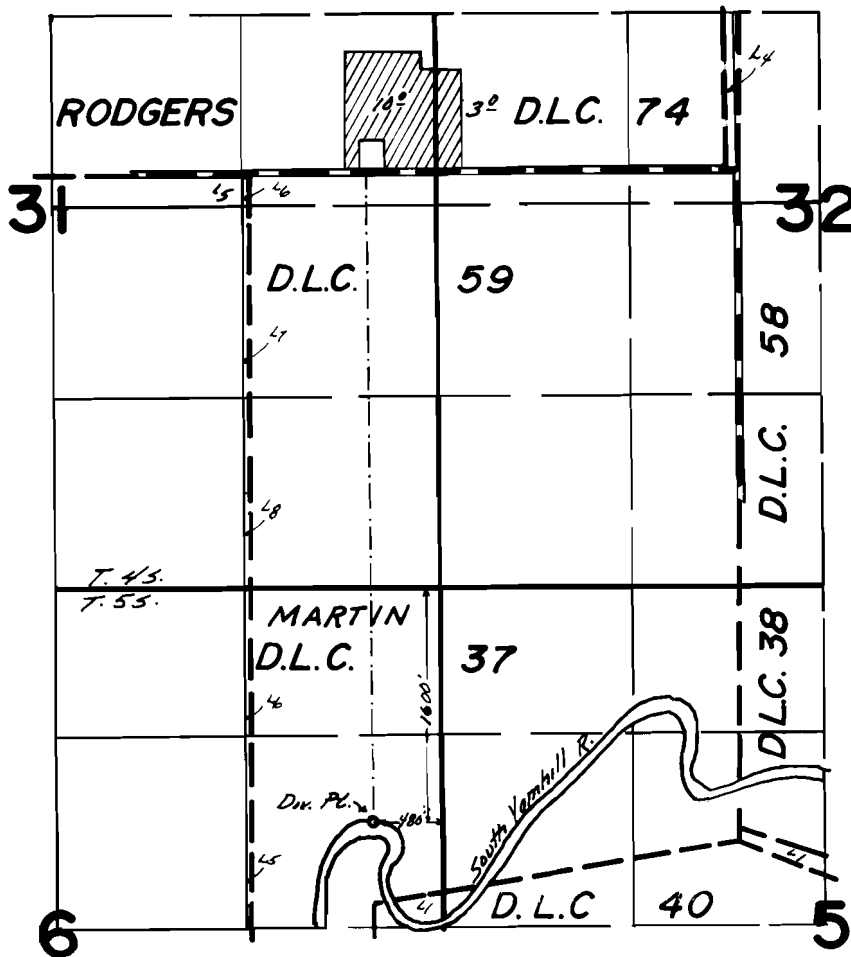

FINAL PROOF SURVEY UNDER

Application No. 55718... Permit No. 41732...
IN NAME OF

RANDY COLEMAN

Surveyed March. 13. 1978., by L.H.Nunn.....