


T. 4S.R.5W.W.M.

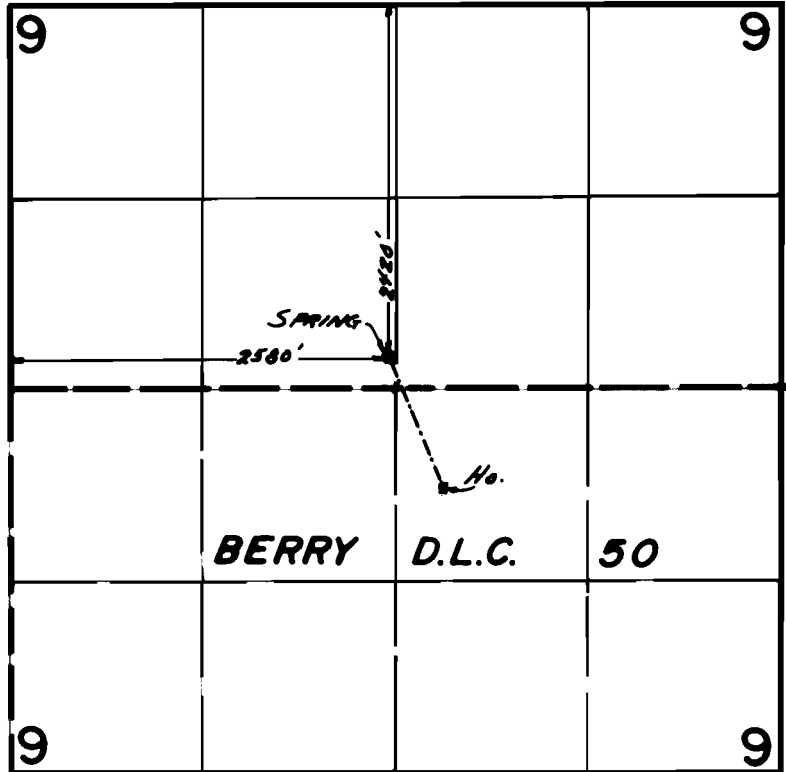

FINAL PROOF SURVEY UNDER

Application No. 56669 Permit No. 42007...
IN NAME OF

.....MATTHEW E. DUNCKEL.....

Surveyed March 21 1978, by L.H.Nunn.....