


T.4S. R.4W. W.M.

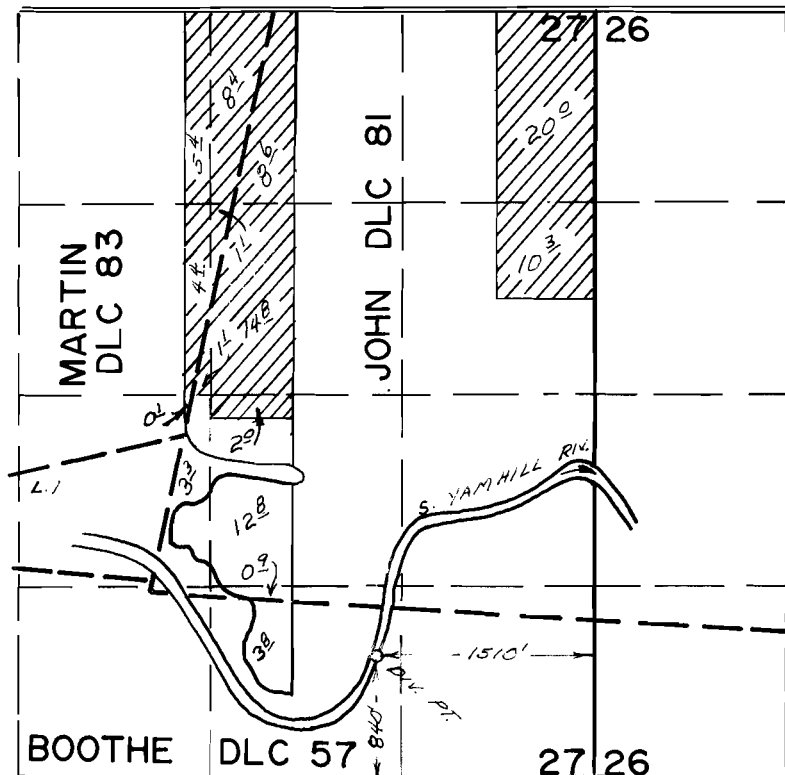

FINAL PROOF SURVEY
UNDER

Application No. 50824 Permit No. 38372
IN NAME OF

ALLEN O. HOLLEY

Surveyed MAR. 16. 1978. by L.H. NUNN