


T.10S., R.6W., W.M.

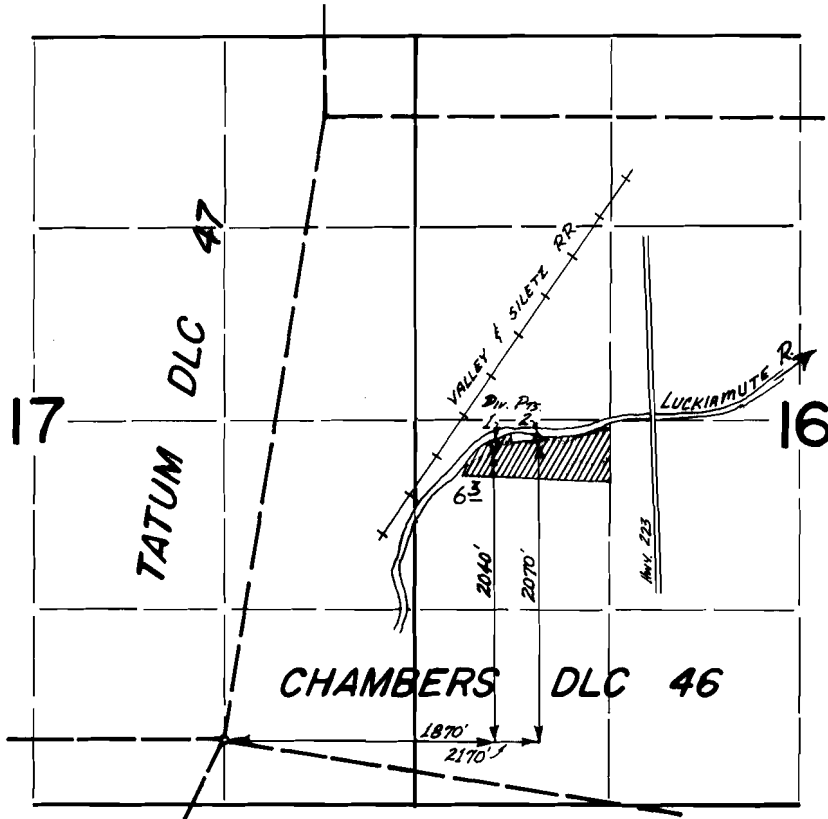

FINAL PROOF SURVEY UNDER

Application No. 53724 Permit No. 40347
IN NAME OF

JOSEPH B. & MARILYN R. MAURAS

Surveyed April 25, 1977, by L.M. TOLL