



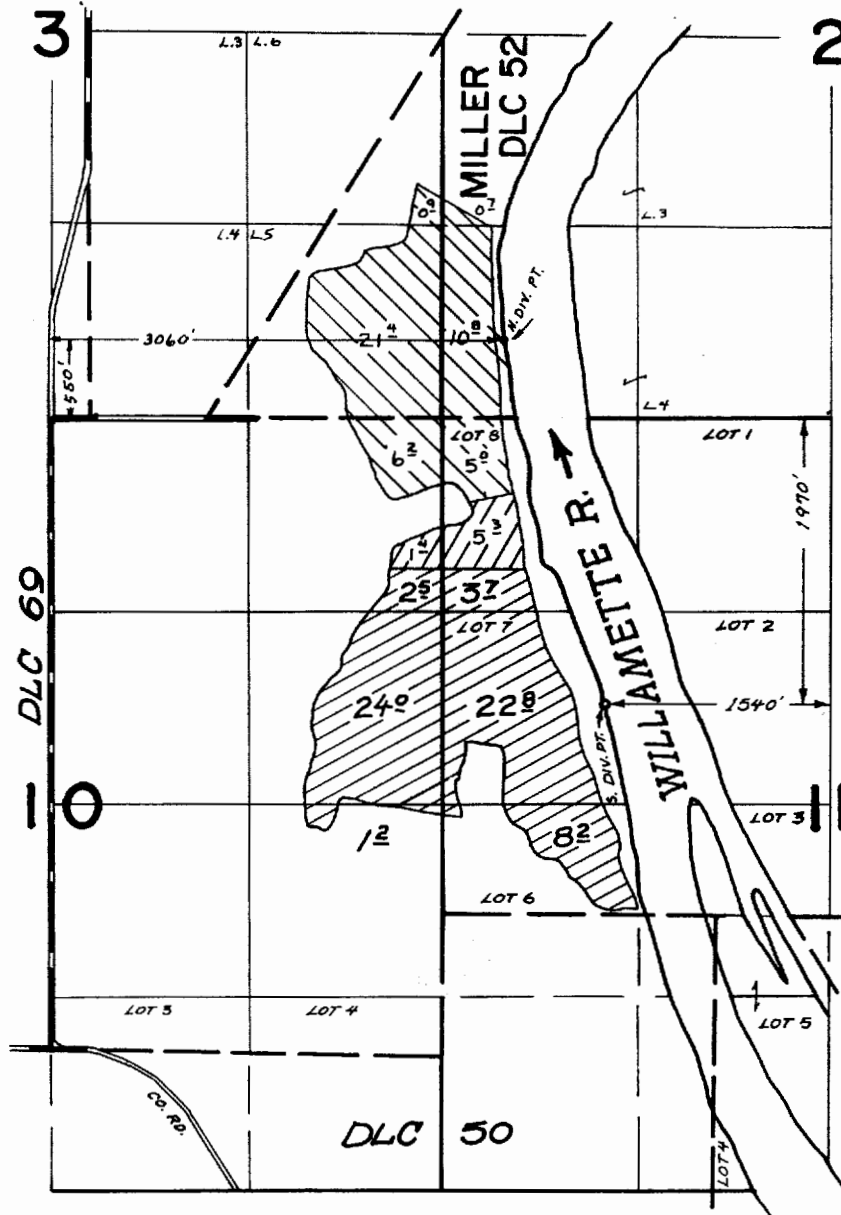

T.10S.,R.4W.,W.M.

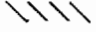

LAND IRRIGATED
UNDER
PERMIT 35084
N. DIV. PT. 
S. DIV. PT. 
PERMIT 35085
S. DIV. PT. 

FINAL PROOF SURVEY UNDER

Application No. ~~46823~~ 46824 Permit No. ~~35084~~ 35085
IN NAME OF

LYON & CAMPBELL, INC.

Surveyed July 5, 1974, by L. M. TOLL
July 17 1974 L. H. NUNN