


T. 10S. R. 4W. W.M.

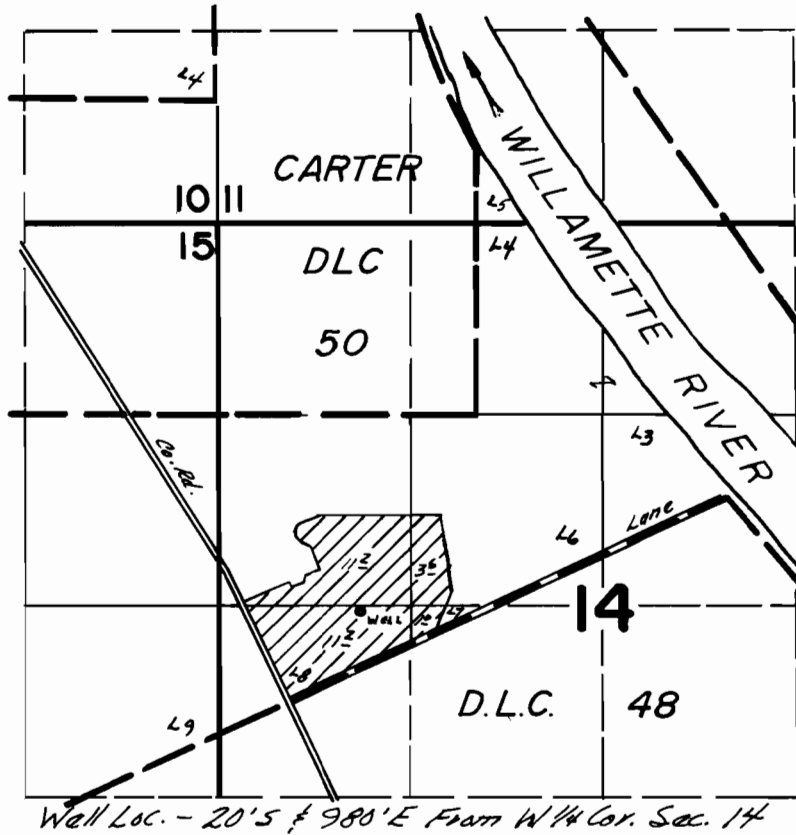

FINAL PROOF SURVEY UNDER

Application No. G-7761. Permit No. G-7202.
IN NAME OF

IVAL HILL

Surveyed April 12, 1978, by J.S. Donaldson...