


T.4N. R.IW. W.M.

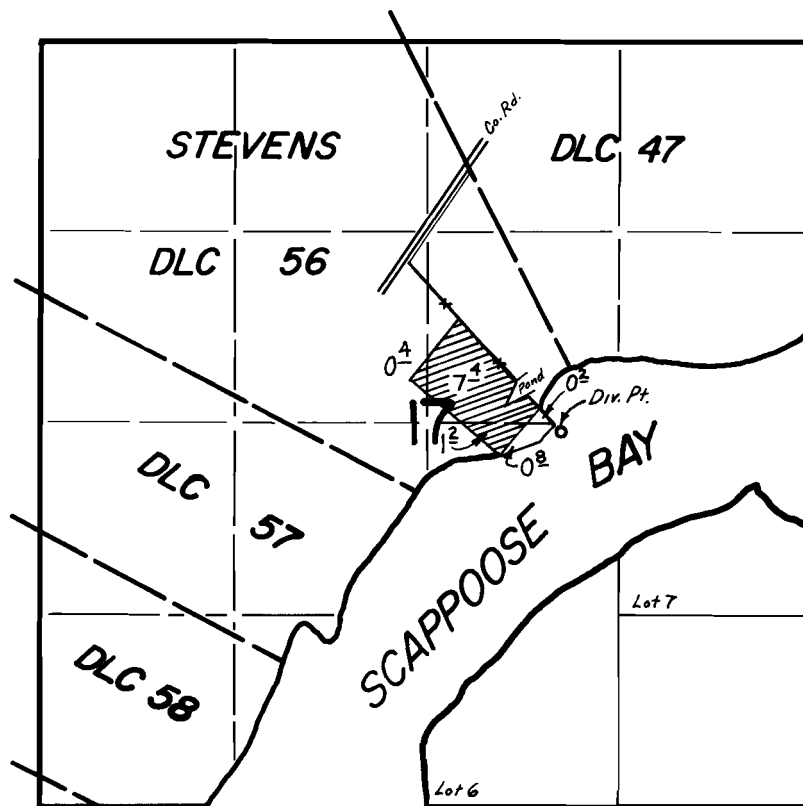

Div Pt. Loc.: 60 ft. S & 920 ft. E. from Center Sec. 17.

FINAL PROOF SURVEY UNDER

Application No. 55283 Permit No. 41478
IN NAME OF

VON N. & IDA L. SMITH

Surveyed Sept 20 1978, by S. P. APPLGATE