


# T. 32 & 33 S., R. 6 W., W.M.

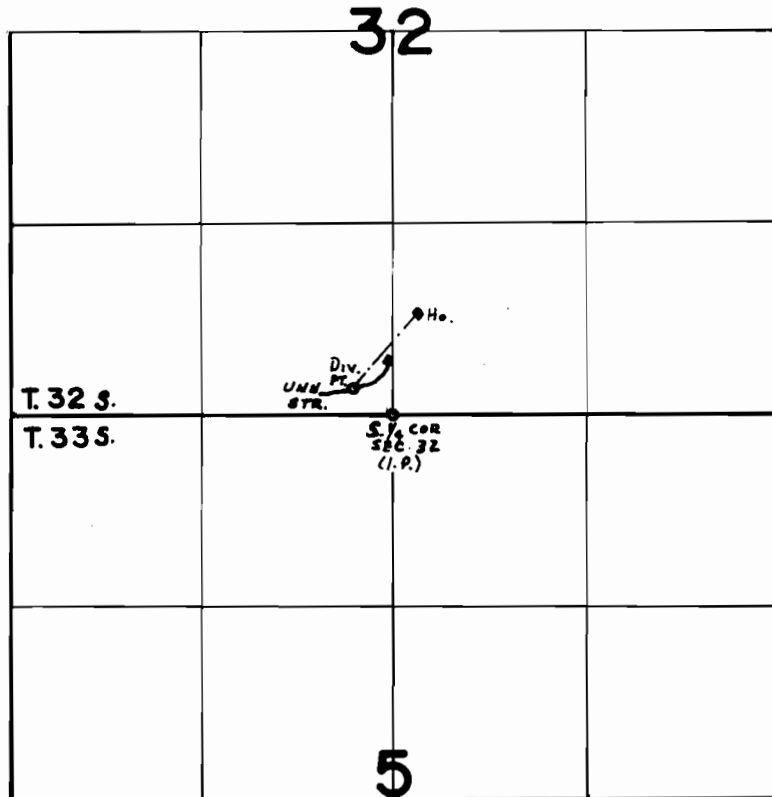

DIV. PT. LOC. 180' N. & 260' W. FROM S. 1/4 COR. SEC. 32

## FINAL PROOF SURVEY UNDER

Application No. 46051... Permit No. 34389...  
IN NAME OF

.....ETHEL L. TROXELL.....

Surveyed MAY 11... 1977, by D.M. NORBY.....