47370
48537

T.36S. R.12E. W.M.

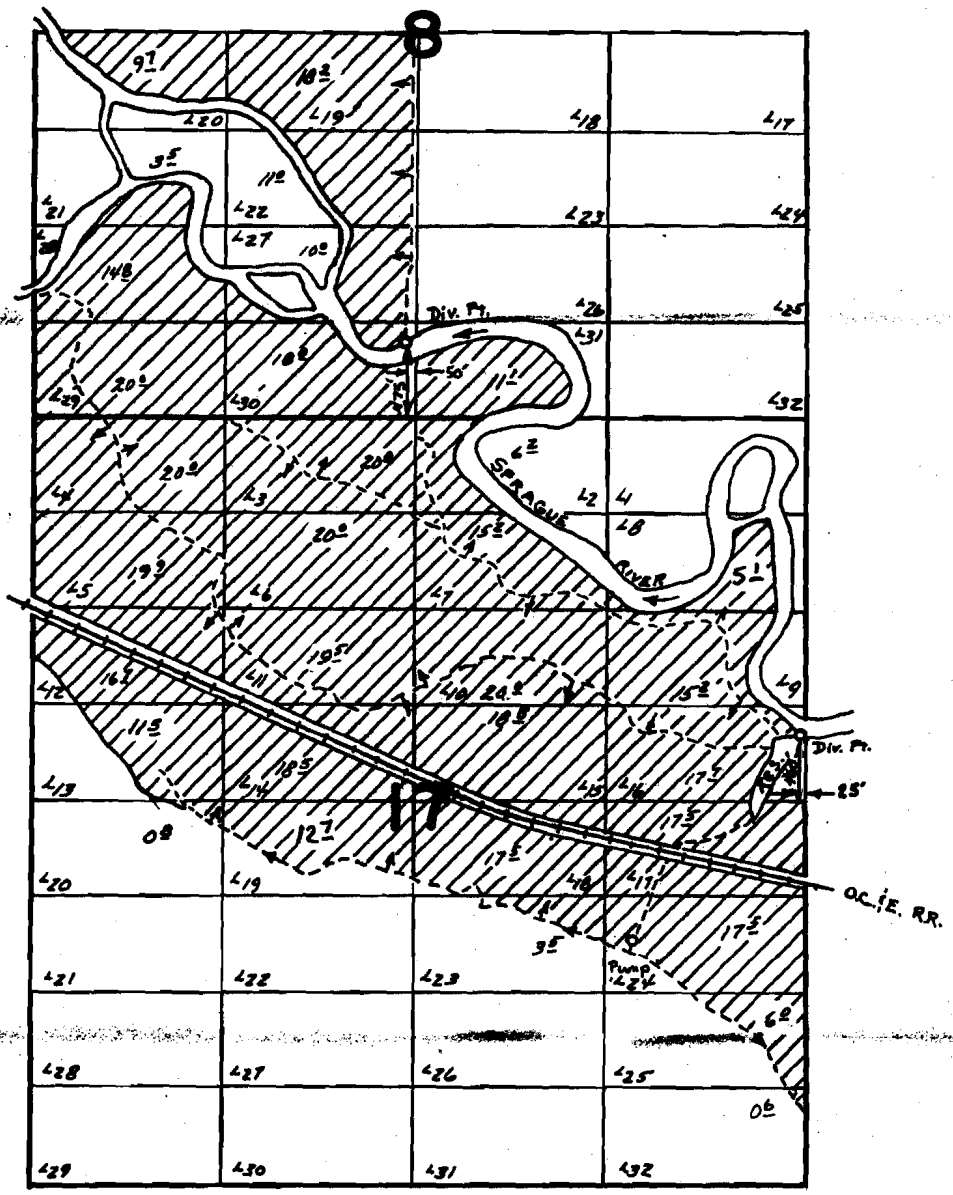

FINAL PROOF SURVEY
UNDER

Application No. 39264 Permit No. 29348
IN NAME OF

PAUL H. & ANN S. FAIRCLO

Surveyed AUG. 23, 1977, by D. NORBY

CNO-433-5 17