


T.17 S., R.5 W., W.M.

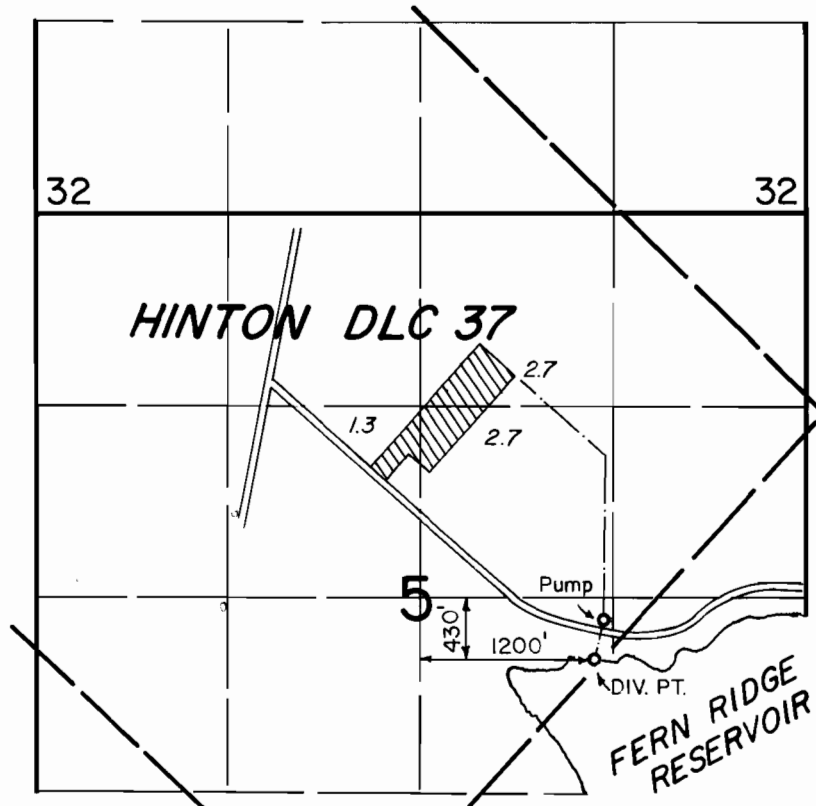

**FINAL PROOF SURVEY**  
UNDER

Application No. 48829 Permit No. 36943  
IN NAME OF

**H. H. & W. M. WEATHERLY**

Surveyed MAY 9, 1978, by L. NUNN