


T. 16 S., R. 6 W., W.M.

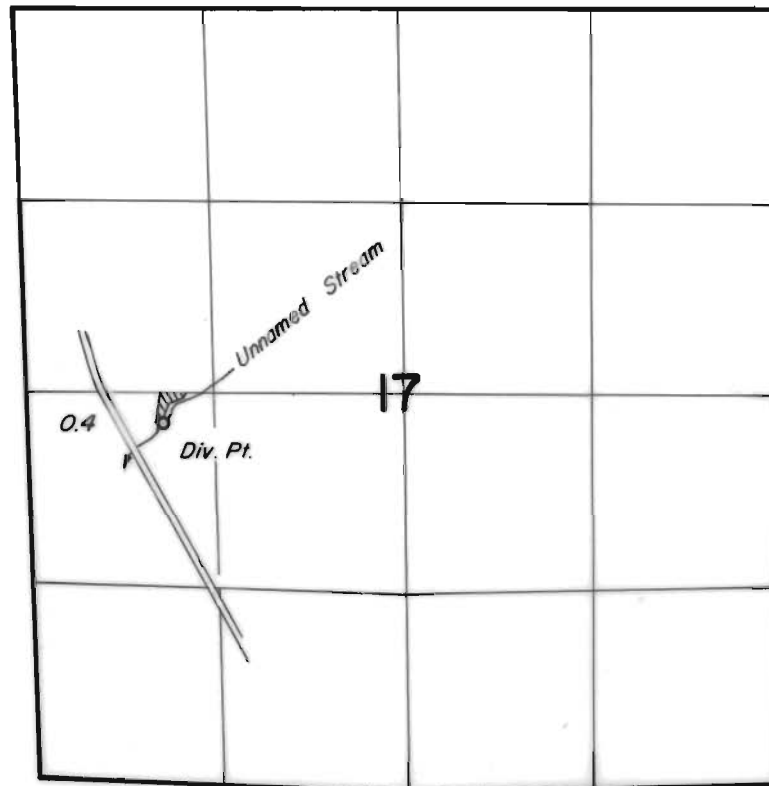

DIV. PT. LOC.: 1150' N. & 350' W. From SE Cor. NW1/4 SW1/4

FINAL PROOF SURVEY
UNDER

Application No. 49807 Permit No. 37467
IN NAME OF

W. L. & GOLDIE M. CRICHTON

Surveyed MAY 23, 1978, by L. NUNN