


T. 16S., R. 5 W., W.M.

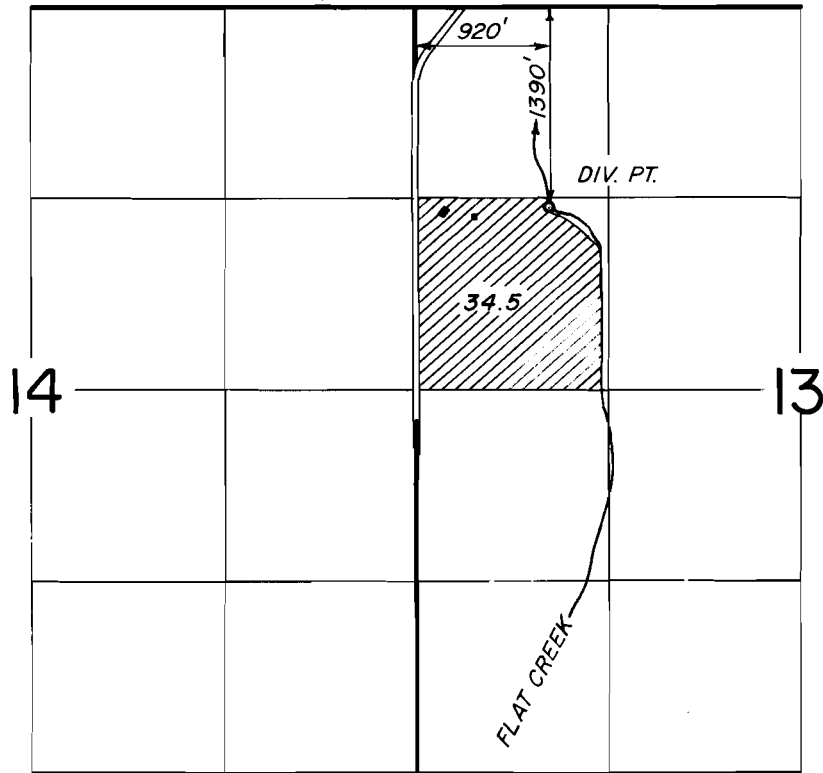

FINAL PROOF SURVEY
UNDER

Application No. 50375 Permit No. 38023
IN NAME OF

JAMES T. FARMER JR.

Surveyed MAY 10, 1978, by L. NUNN