


T.18S., R.11W., W.M.

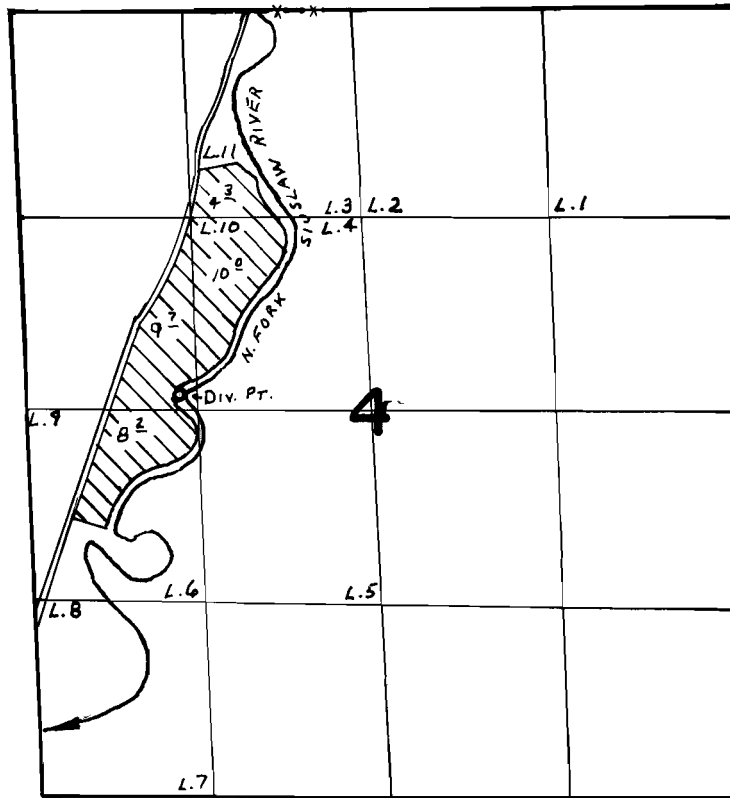

DIV. LOC: 2620'S. & 1180'W. FROM N 1/4 COR. SEC. 4

FINAL PROOF SURVEY UNDER

Application No. 50749 Permit No. 38329
IN NAME OF

GEORGE G. & ANITA ESGATE, JR

Surveyed SEPT. 14 1976, by L. TOLL