




T.16S. R.4W., W.M.

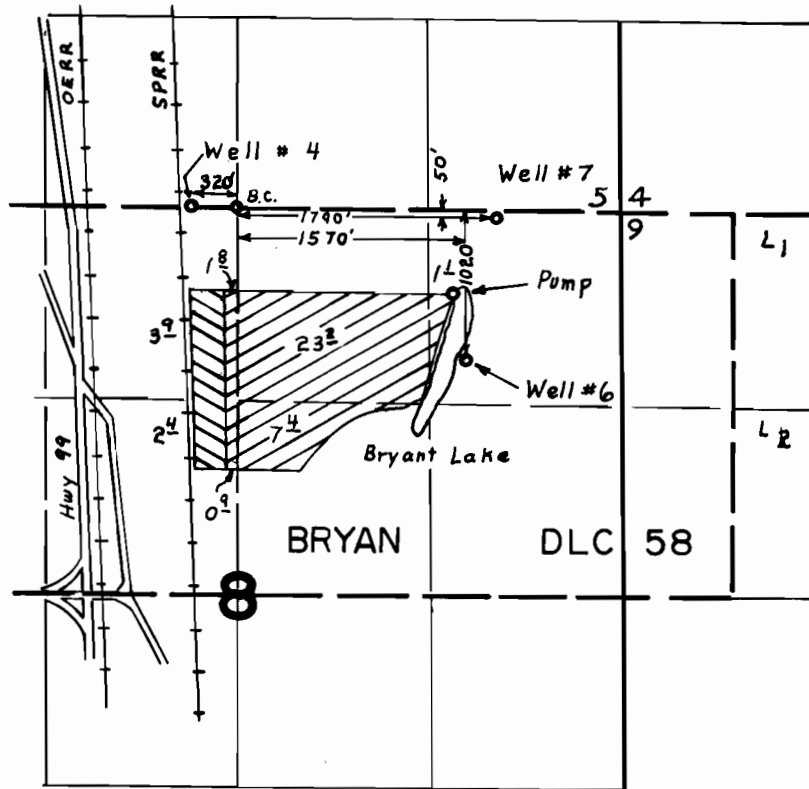

 Primary
 Supplemental

FINAL PROOF SURVEY UNDER

Application No. G-8052. Permit No. G-7458.
IN NAME OF

STROME - FISHER FARM, INC.

Surveyed APR. 27. 1978., by J.S. DONALDSON