


TIOS. R. IOW. W.M.

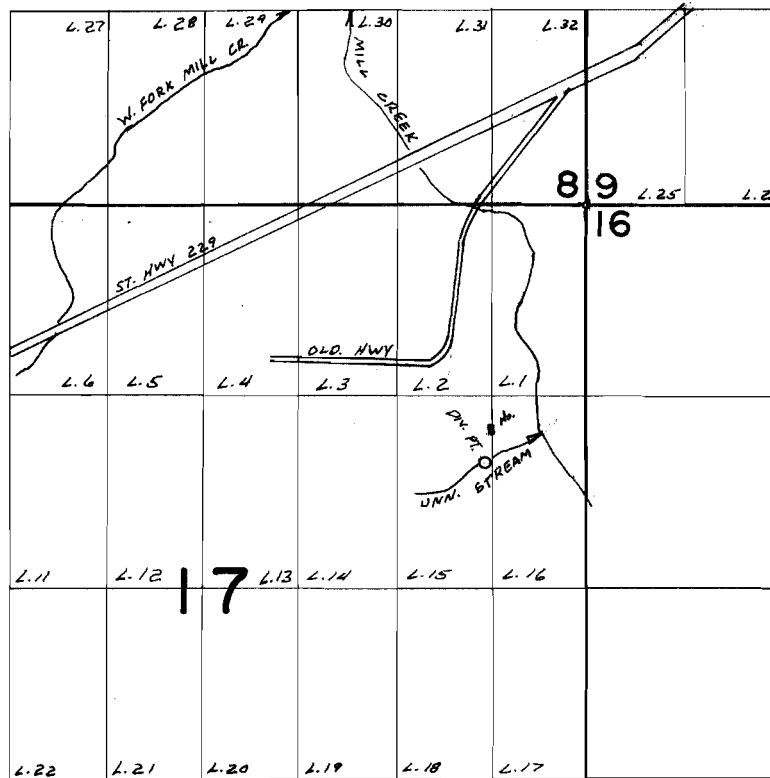

DIV. PT. LOC. 1770'S & 700' W FROM NE COR SEC. 17

FINAL PROOF SURVEY UNDER

Application No. 50182 Permit No. 37691
IN NAME OF

HARRY J. SHUBIN

Surveyed OCT. 7 1975, by L.H. NUNN