


T.6S. R.3W. W.M.

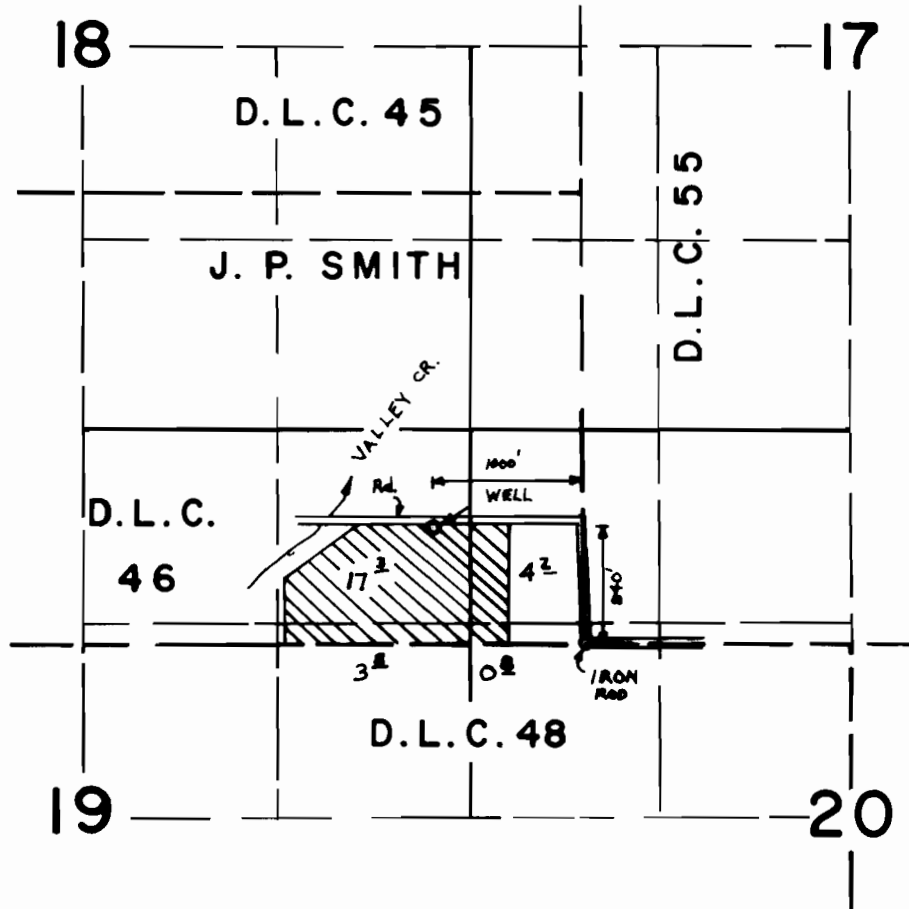

FINAL PROOF SURVEY
UNDER

Application No. G-5841 Permit No. G-5584
IN NAME OF

LOREN E. POWELL

Surveyed June 2, 1976, by R.G. Mucken