


T.2N.,R.10W.,W.M.

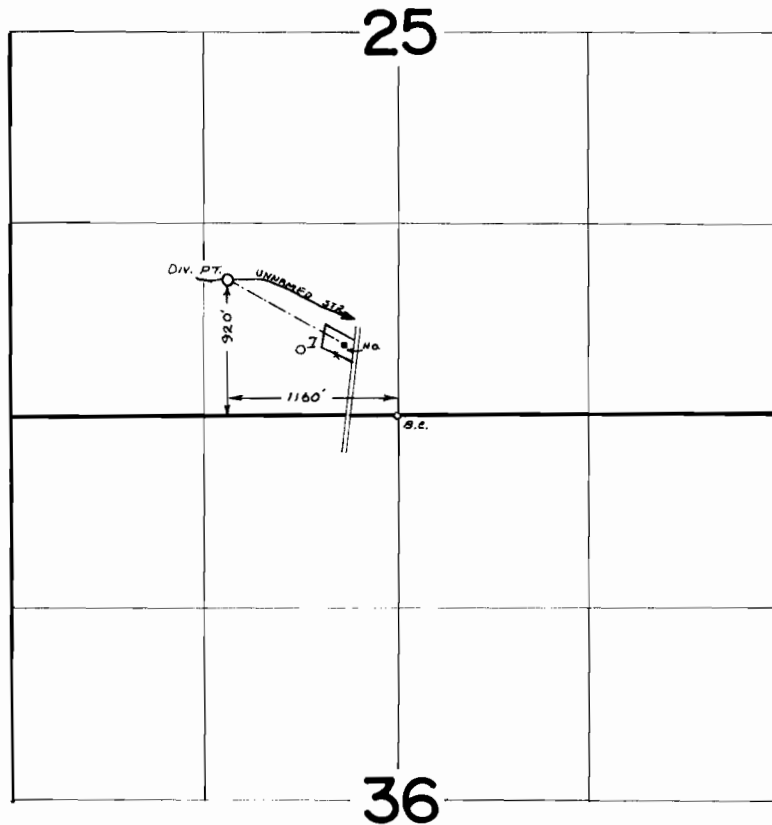

FINAL PROOF SURVEY
UNDER

Application No. **49768**... Permit No. **36534**...
IN NAME OF

JAMES R. PARK

Surveyed JUNE 27 1974, by D. NORBY.....