


T.4S.R.4W.W.M.

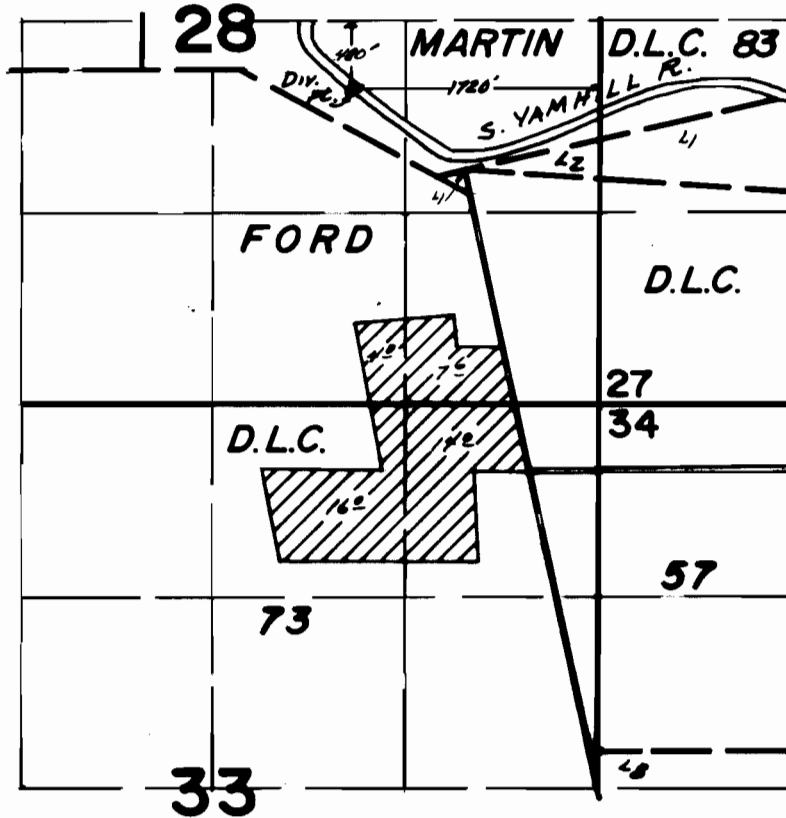

FINAL PROOF SURVEY UNDER

Application No. 56206.. Permit No. 42244..
IN NAME OF

.....HERBERT COLEMAN.....

Surveyed March 13 1978., by L.H.Nunn.....