


T 7 S. R 1 W. W. M.

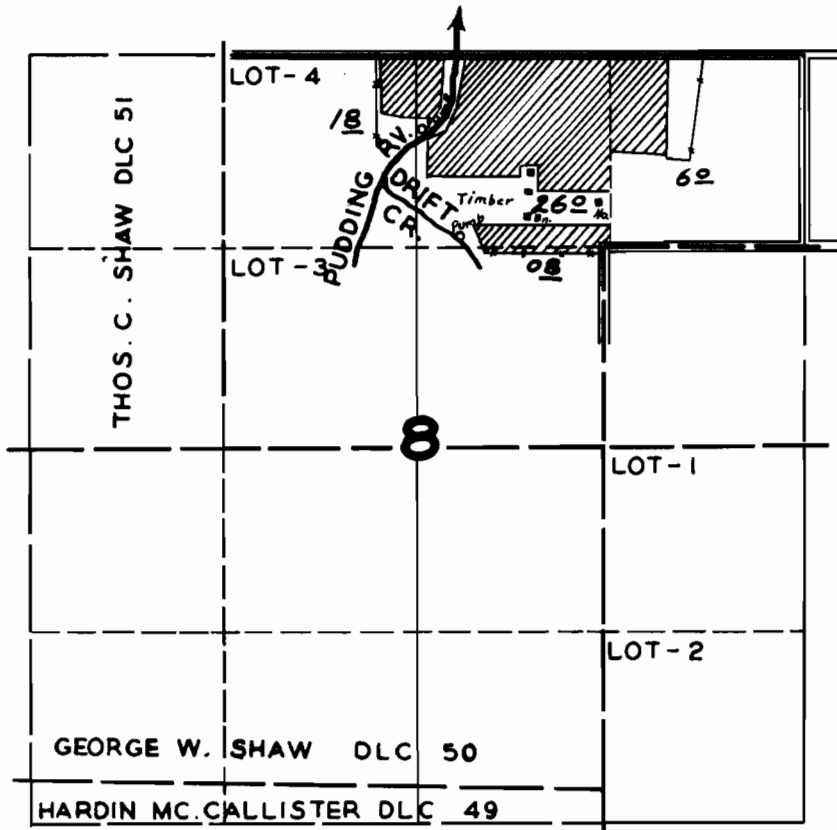

FINAL PROOF SURVEY UNDER

Application No. 18911 Permit No. 14522

IN NAME OF

ERNEST STADEL

Surveyed JUNE -7 1944, by

James Burnell