


# T. 8 S. R. 4 W. W. M.

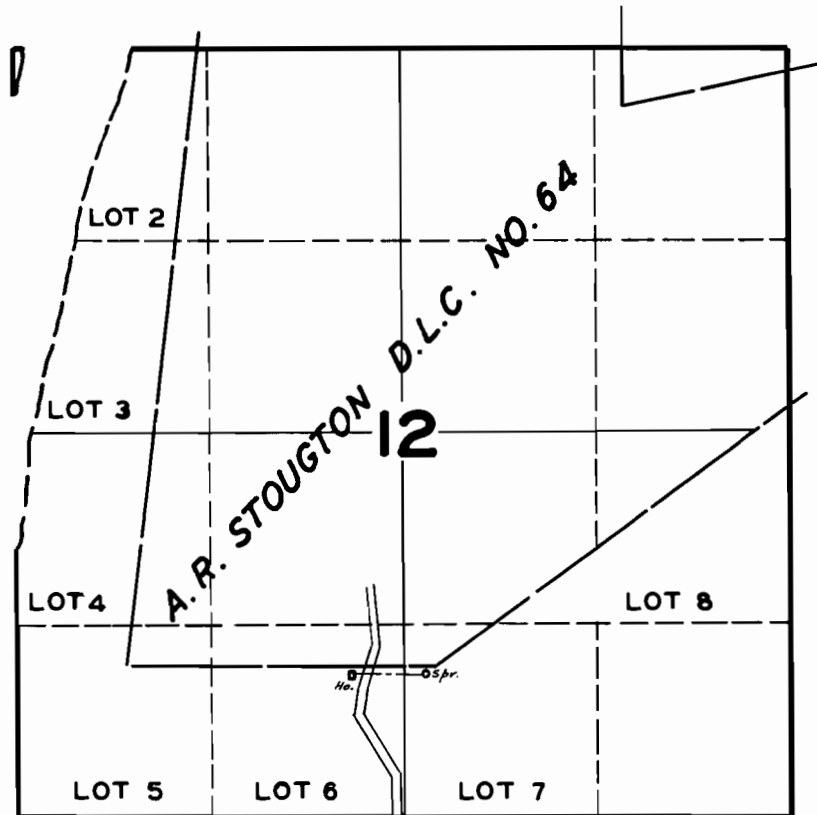

DISTANCES SHOWN ON APPLICANTS MAP  
ARE ACCEPTED

## FINAL PROOF SURVEY

UNDER

Application No. **22468** Permit No. **17715**

IN NAME OF

**A. D. GRAHAM**

Surveyed **OCT. 8**, 1947, by **JAS. E. BUNNELL**