


T. 7 S. R. 1 E. W. M.

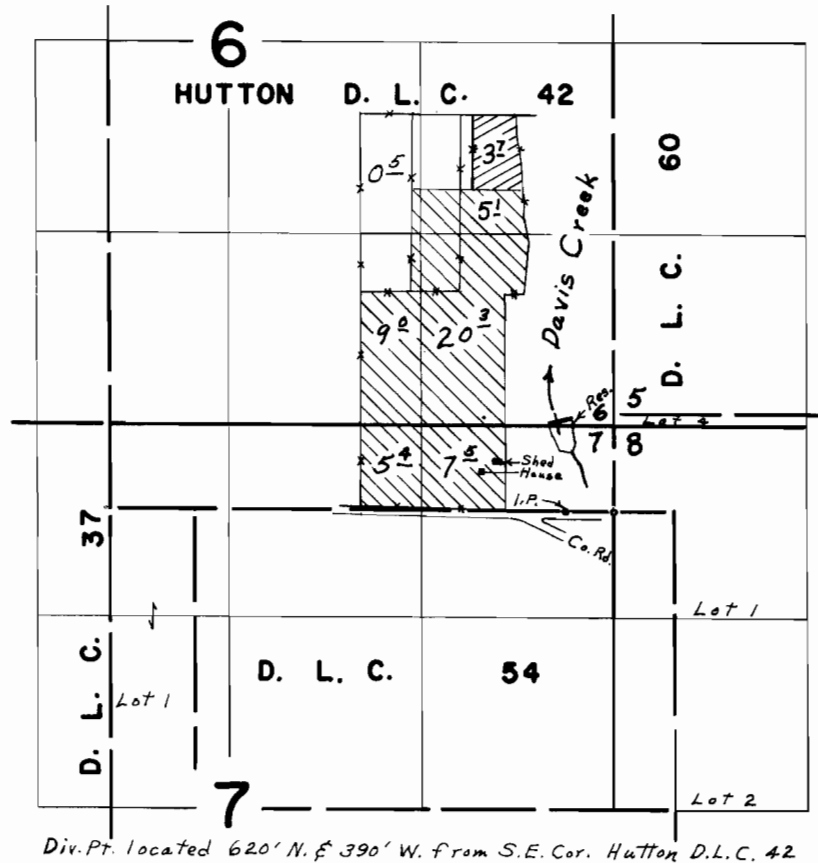

Div. Pt. located 620' N. & 390' W. from S.E. Cor. Hutton D.L.C. 42

FINAL PROOF SURVEY UNDER

TR. 2541 
41330
R-41591
Application No. 44216 Permit No. 33028
IN NAME OF
FREDERICK P. PATTERSON

Surveyed July 5, 1968, by L. E. Gould
JUNE 2, 1975 R.G. Mucken