


T.14S. R.5W. W.M.

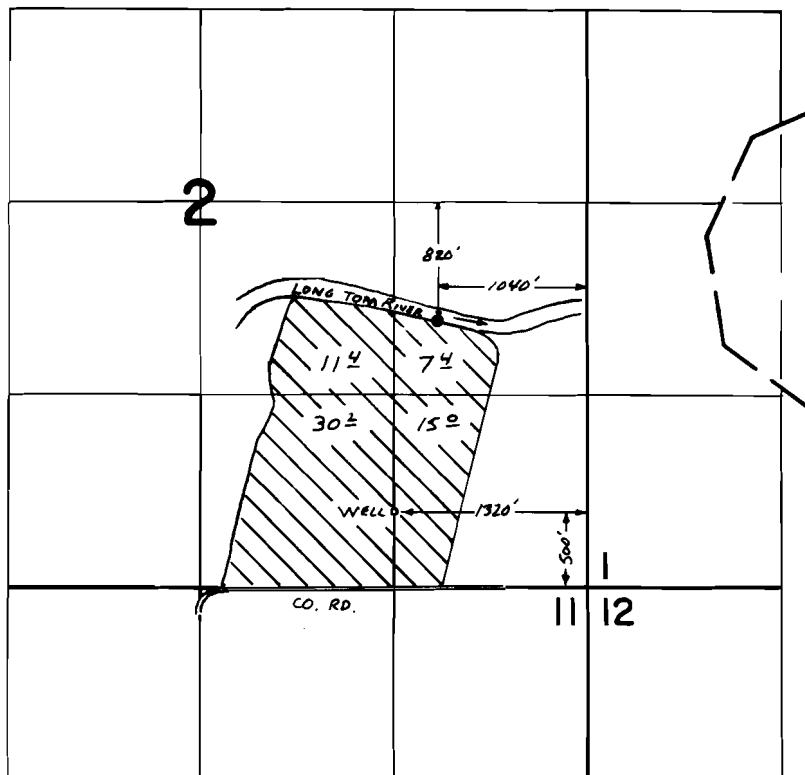

FINAL PROOF SURVEY
UNDER

55676 41708—Supplemental
Application No. G-6824 Permit No. G-6084-Primary
IN NAME OF

PAUL RIGOR

Surveyed JUNE 3, 1977, by L. M. TOLL
MARCH 23, 1978—J.S. DONALDSON