


T.11S., R.4W., W.M.

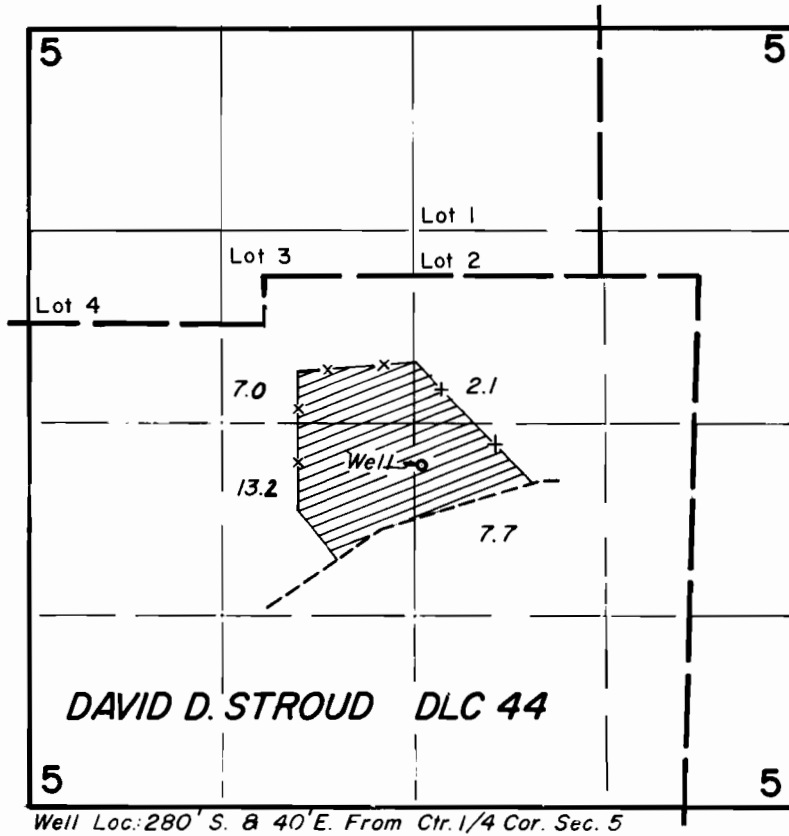

FINAL PROOF SURVEY
UNDER

Application No. G-6871 Permit No. G-6407
IN NAME OF

Newton Brothers, Inc.

Surveyed Oct. 5, 1978, by S. Applegate