


T. 3 S., R. 1 W., W.M.

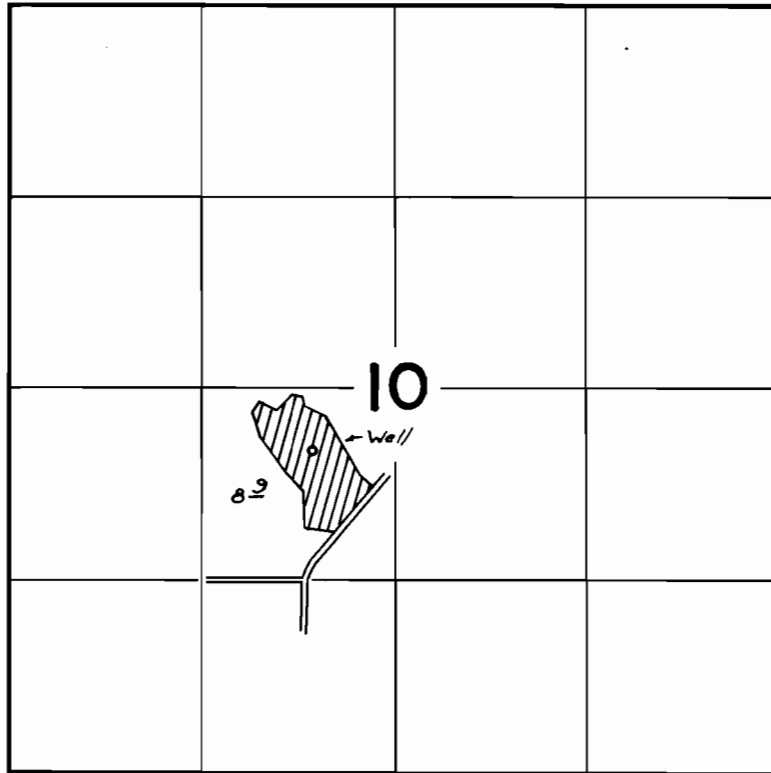

Well Loc.: 440 'S. & 560 'W. from ctr. $\frac{1}{4}$ cor., Sec 10

FINAL PROOF SURVEY UNDER

Application No. G-6880 Permit No. G-6412
IN NAME OF

Lee & Marion Thompson

Surveyed Aug 2, 1977, by JCBrown