


T.27S., R.12W., W.M.

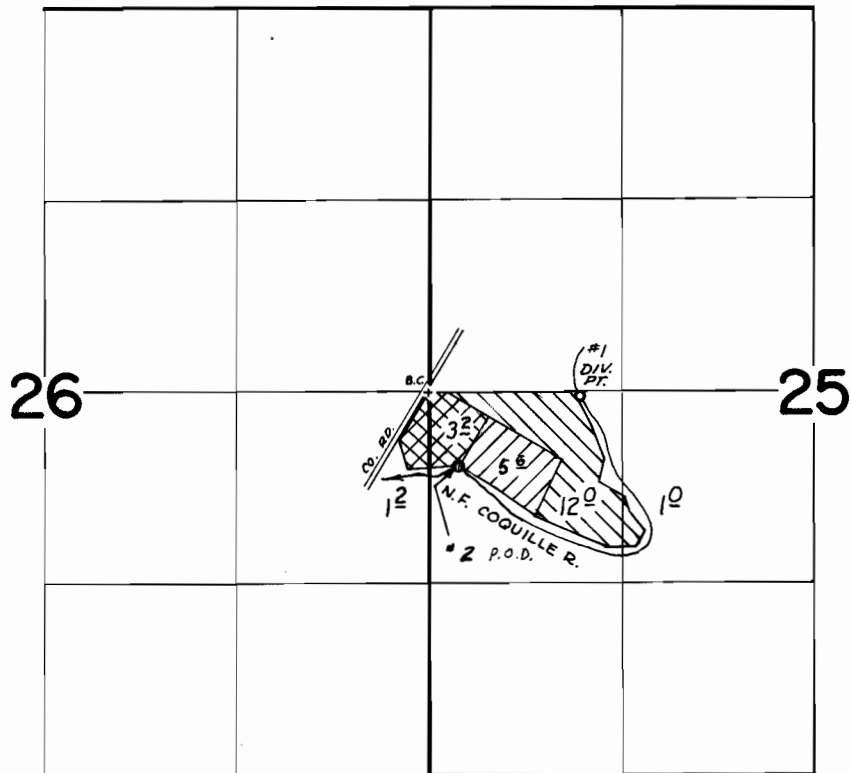

DIV. PT. LOC: \*1 30' S & 1040' E FROM W 1/4 COR. SEC. 25  
\*2 510' S & 210' E FROM W 1/4 COR.

**FINAL PROOF SURVEY**  
UNDER

Application No. 50443 Permit No. 38098  
51351 38836  
IN NAME OF



\*1 P.O.D.

\*2 P.O.D.

WILBUR T. BOONE

Surveyed July 15 1976, by D. Norby