


T.25S.,R.13W.,W.M.

SEC. 13

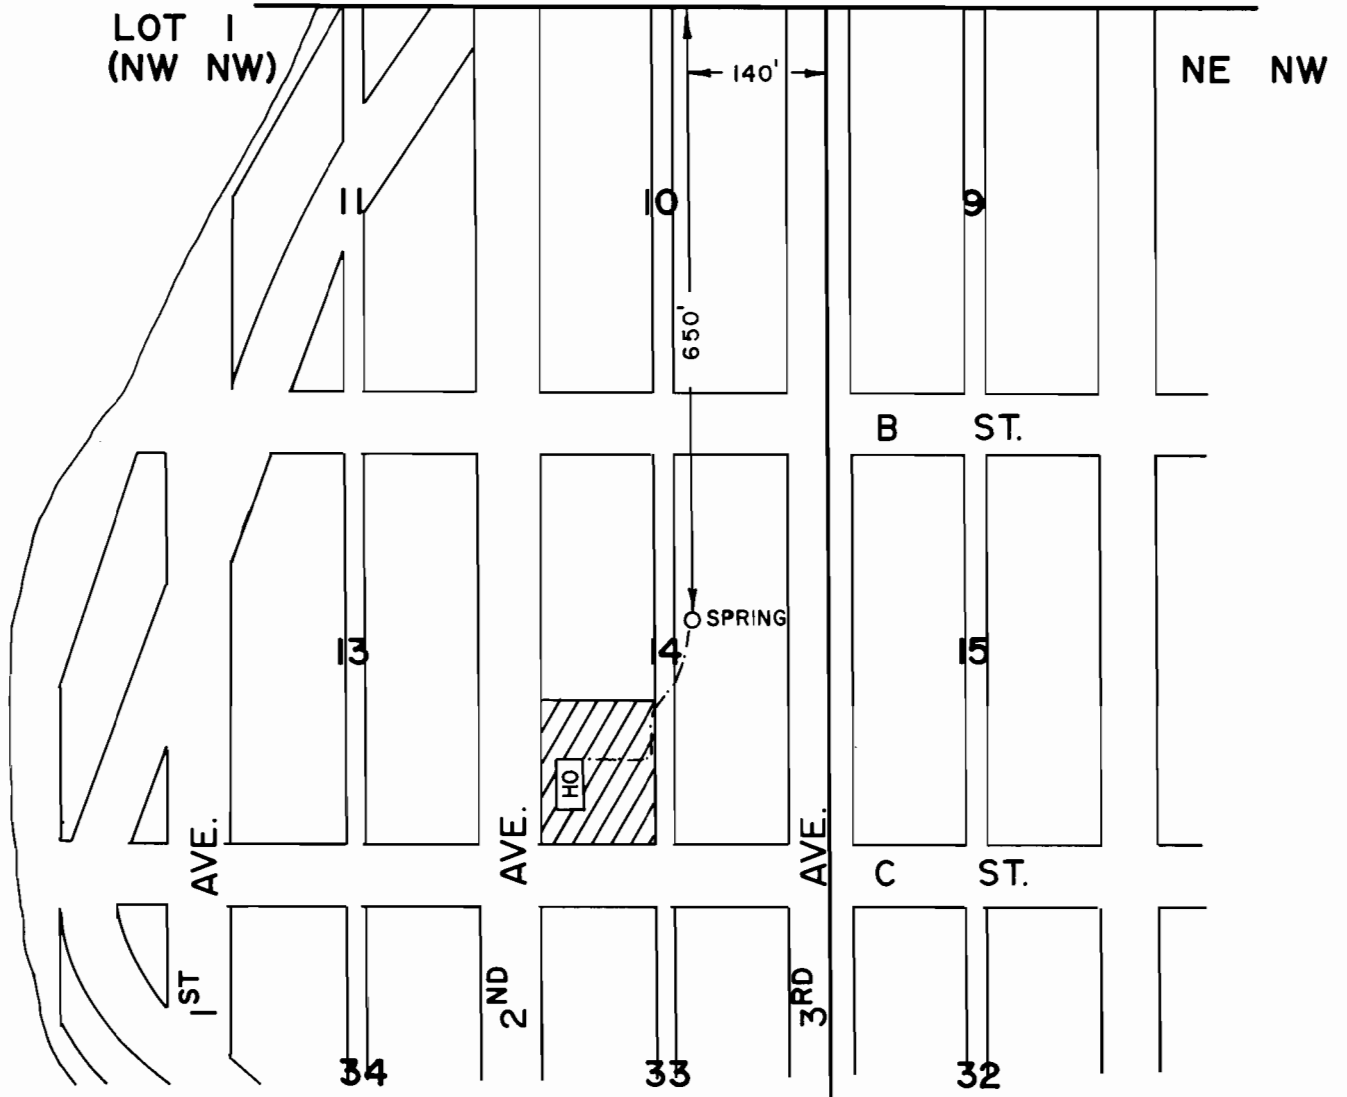

SCALE: 1" = 200'

FINAL PROOF SURVEY
UNDER

Application No. 51538 Permit No. 38883
IN NAME OF

.....
Surveyed MAY 26 1976, by L. TOLL.....