


T. 38 S., R. 5 W., W. M.

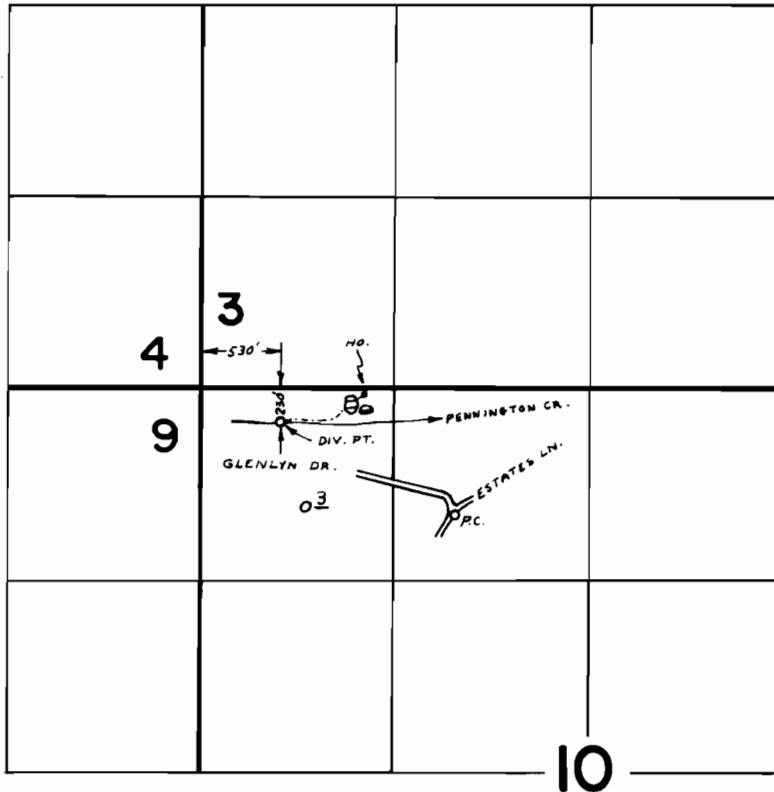

FINAL PROOF SURVEY UNDER

Application No. 50577 Permit No. 38183
IN NAME OF

DAVID R. STANLEY

Surveyed OCT. 18 1978, by B. SUND