


T. 39 S., R. 5 W., W.M.

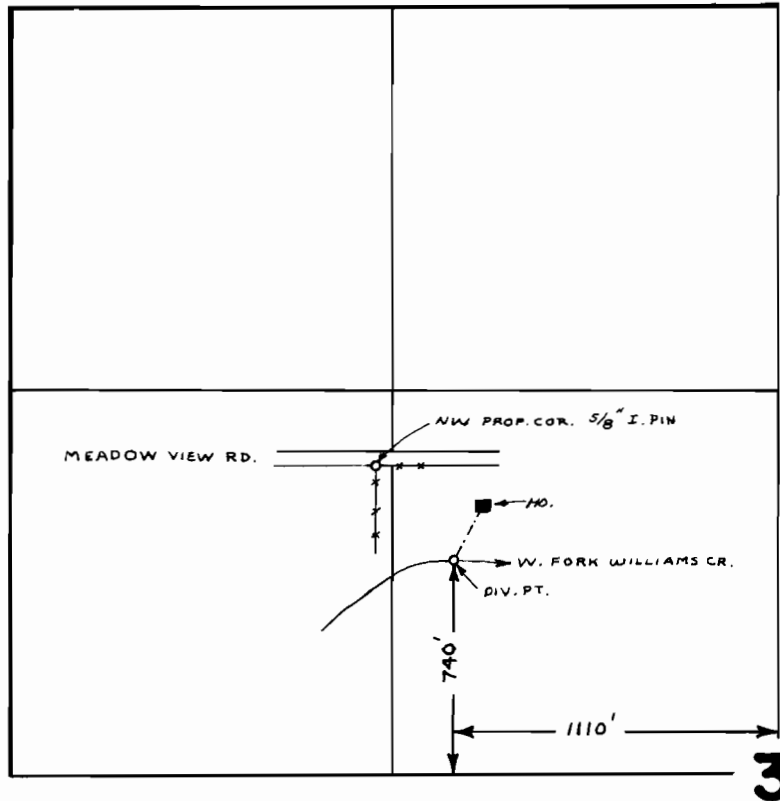

SCALE: 1" = 660 FT.

**FINAL PROOF SURVEY**  
UNDER

TR-3357

Application No. 53980 Permit No. 42149  
IN NAME OF

LARRY T. MCVEY

Surveyed SEPT. 15 1978, by B. SUND