


# T.38S. R.8E., W.M.

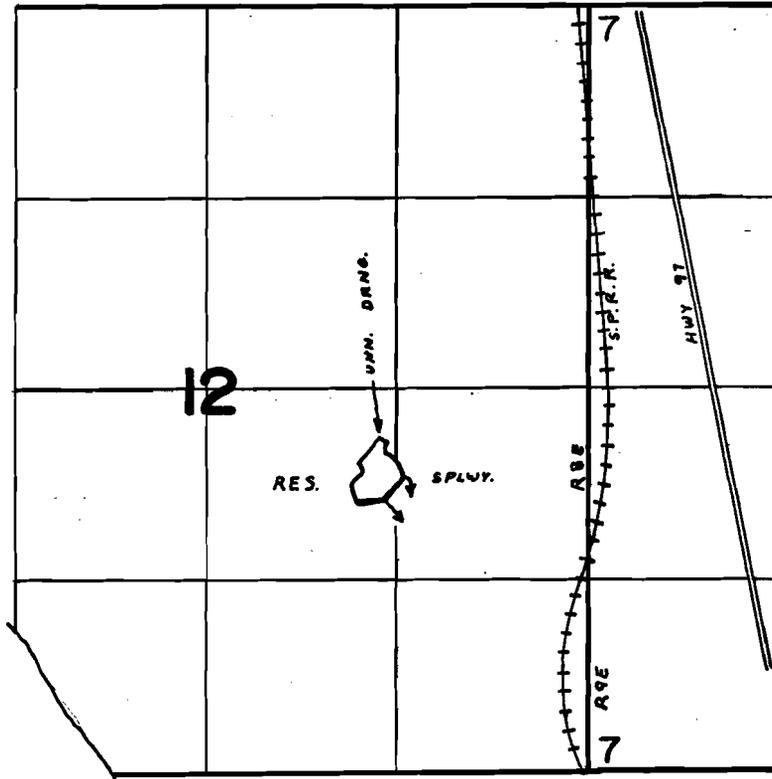

Upper Klamath Lake : Misc.

## FINAL PROOF SURVEY UNDER

Application No. R-54250 Permit No. R-6489...  
IN NAME OF

.....D. T. MATTHEWS.....

Surveyed JUL. 27... 1978., by S. P. APPLGATE

*(change map on index in large map file)*