


T.18S.,R.10W.,W.M.

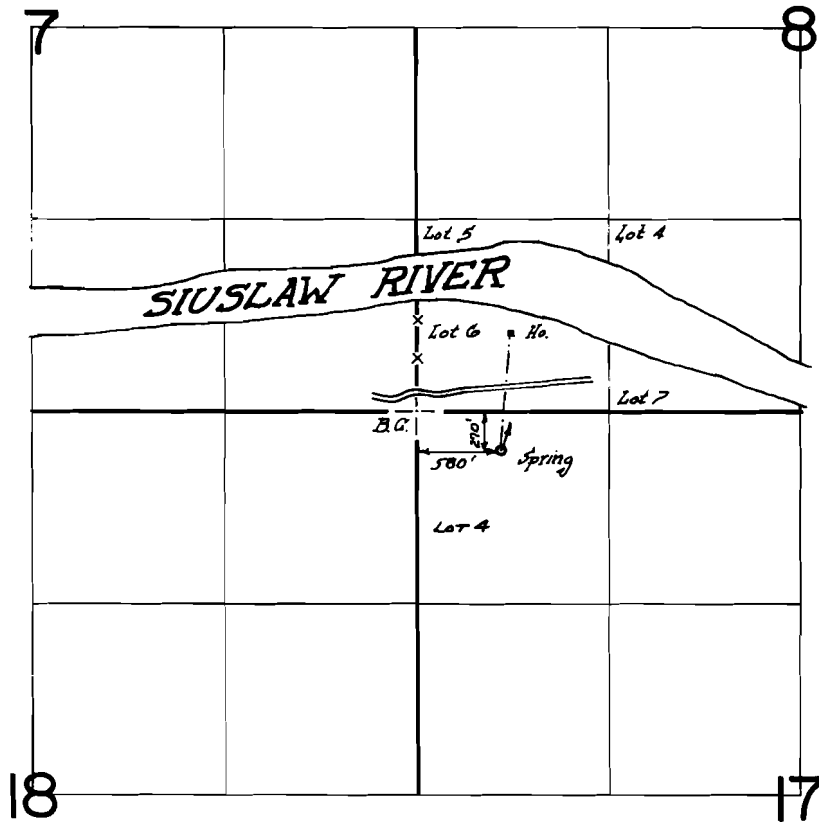

**FINAL PROOF SURVEY**  
UNDER

Application No. 56573 Permit No. 42458  
IN NAME OF

ALBERT TEKANDER

Surveyed Sept. 14, 1978, by S.P. Applegate