


42594
48596

T.37S. R.5E., W.M.

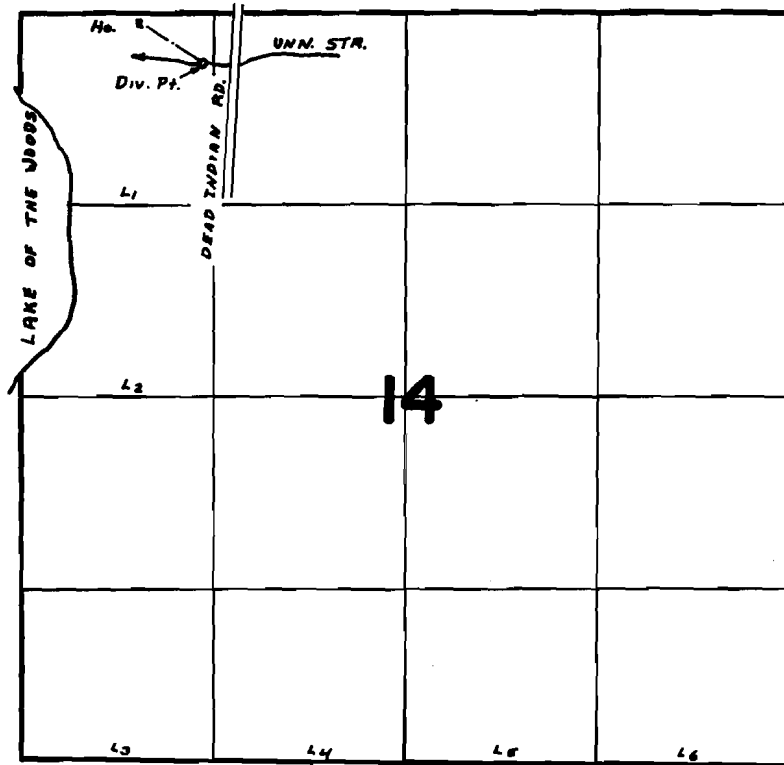

Div. Pt. Loc. 350'S. & 1250'E. From N.W. Cor. Sec. 14

Joanne Ue. & more.

FINAL PROOF SURVEY UNDER

Application No. 56766... Permit No. 42594...
IN NAME OF

.....JOAN DEAN WILLIAMS.....

Surveyed JUL. 29. 1978. by S.P. APPLGATE