


42883
48599

T.39S. R.7&8E., W.M.

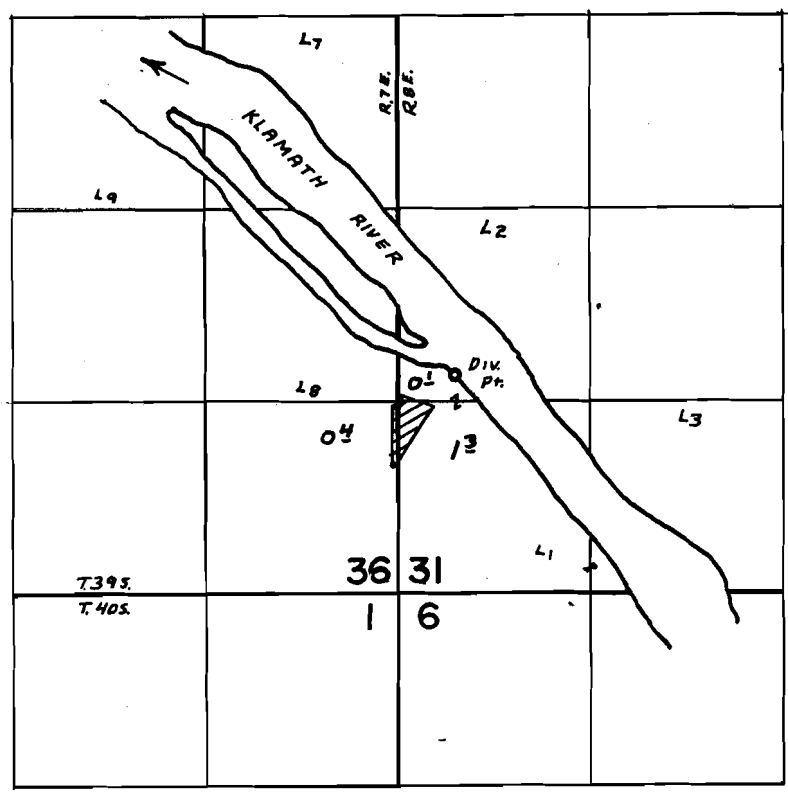

Div. Ph. Loc. 1500' N. & 390' E. From S.W. Cor. Sec. 31

FINAL PROOF SURVEY UNDER

Application No. 56092... Permit No. 42883...
IN NAME OF

J. W. CROSSLIN

Surveyed JUL. 27. 1978., by S.P. APPELEGATE

Klamath River