


43106
48600

DR. ROBERT E. DODGE
6345 SW SEYMOUR ST
PORTLAND, OREGON

LOT B-3 LAKE OF THE WOODS
T37S R5E
SECTION 14

Journal Case: Misc.

LAKE
OF THE
WOODS

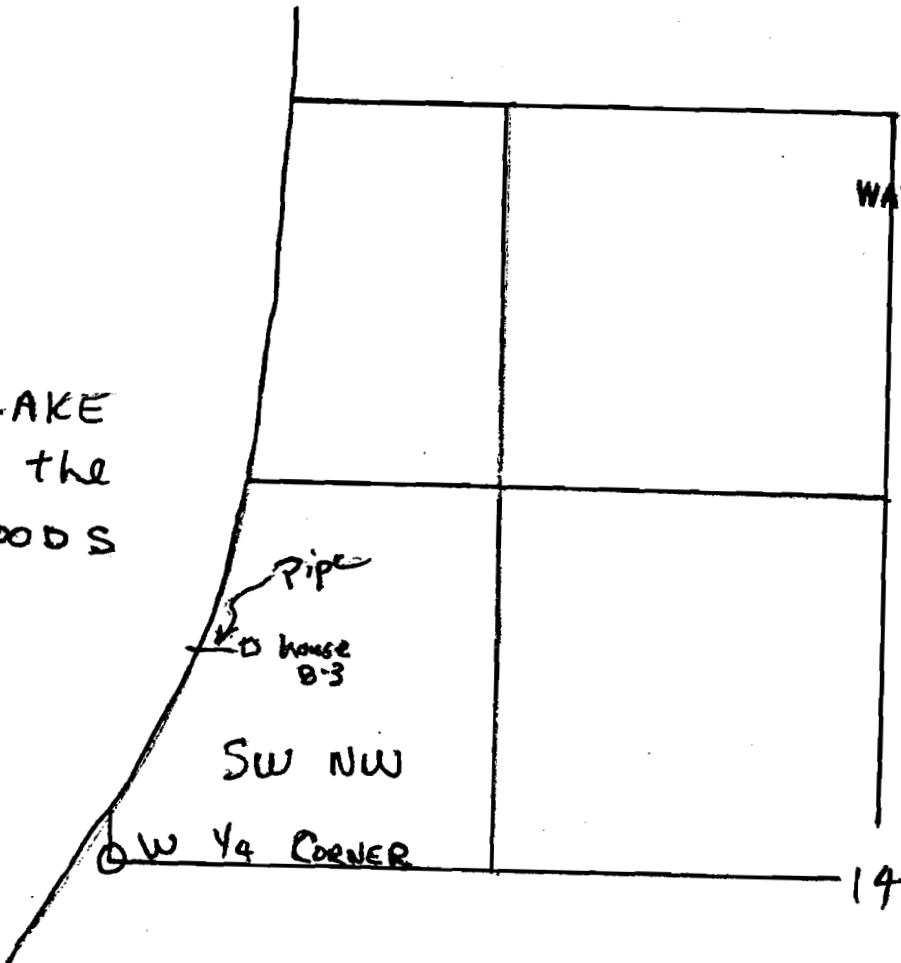

RECEIVED
APR 10 1978
WATER RESOURCES DEPT.
SALEM, OREGON

Application No. 57297
Permit No. 43106

Scale 8" = 1 mile