


6-7139

48601

T.41S. R.10E., W.M.

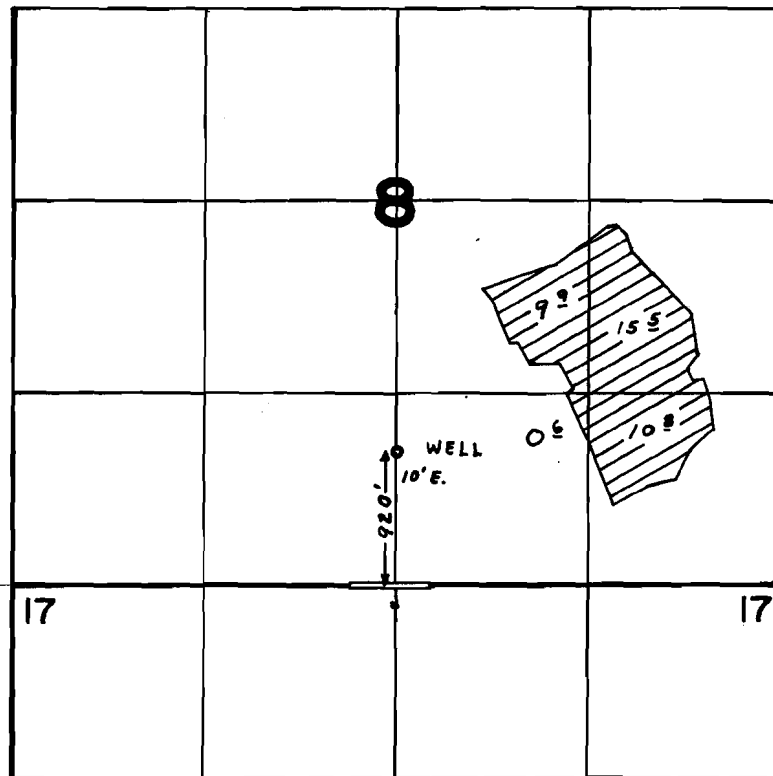

about Bu. Wells

FINAL PROOF SURVEY UNDER

Application No. G-7582... Permit No. G-7139....
IN NAME OF

.....CHARLES G. KERR.....

Surveyed JUL...31... 1978., by S.P. APPLGATE