


Application No. **B 8491** 48605

Permit No. G 7997

T.37S.,R.5E.,W.M.

WATER RESOURCES DEPT
SALEM, OREGON

Four mile c/c: Misc.

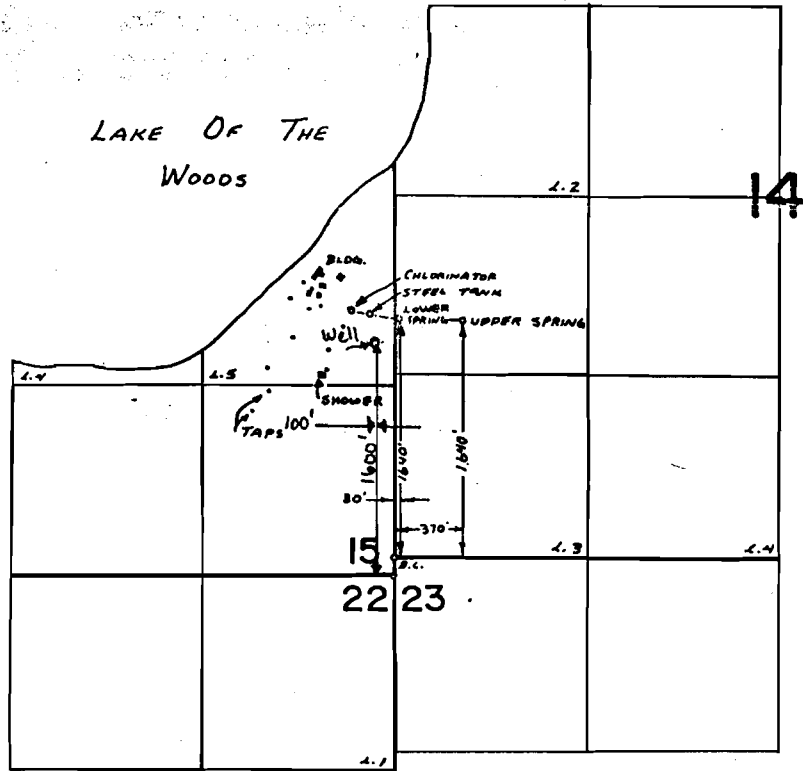

FINAL PROOF SURVEY
UNDER

Application No. **43771** Permit No. **32709**
IN NAME OF

WINEMA GIRL SCOUT COUNCIL, INC.

Surveyed **July 16, 1975**, by **A. E. Gould**

RECEIVED

MAR 14 1978

WATER RESOURCES DEPT.
SALEM, OREGON